


DATE & TIME: 2/5/2024 4:34:05 PM


1 OVERALL FIRST FLOOR DEMOLITION PLAN

AD100 SCALE: 1/8" = 1'-0"

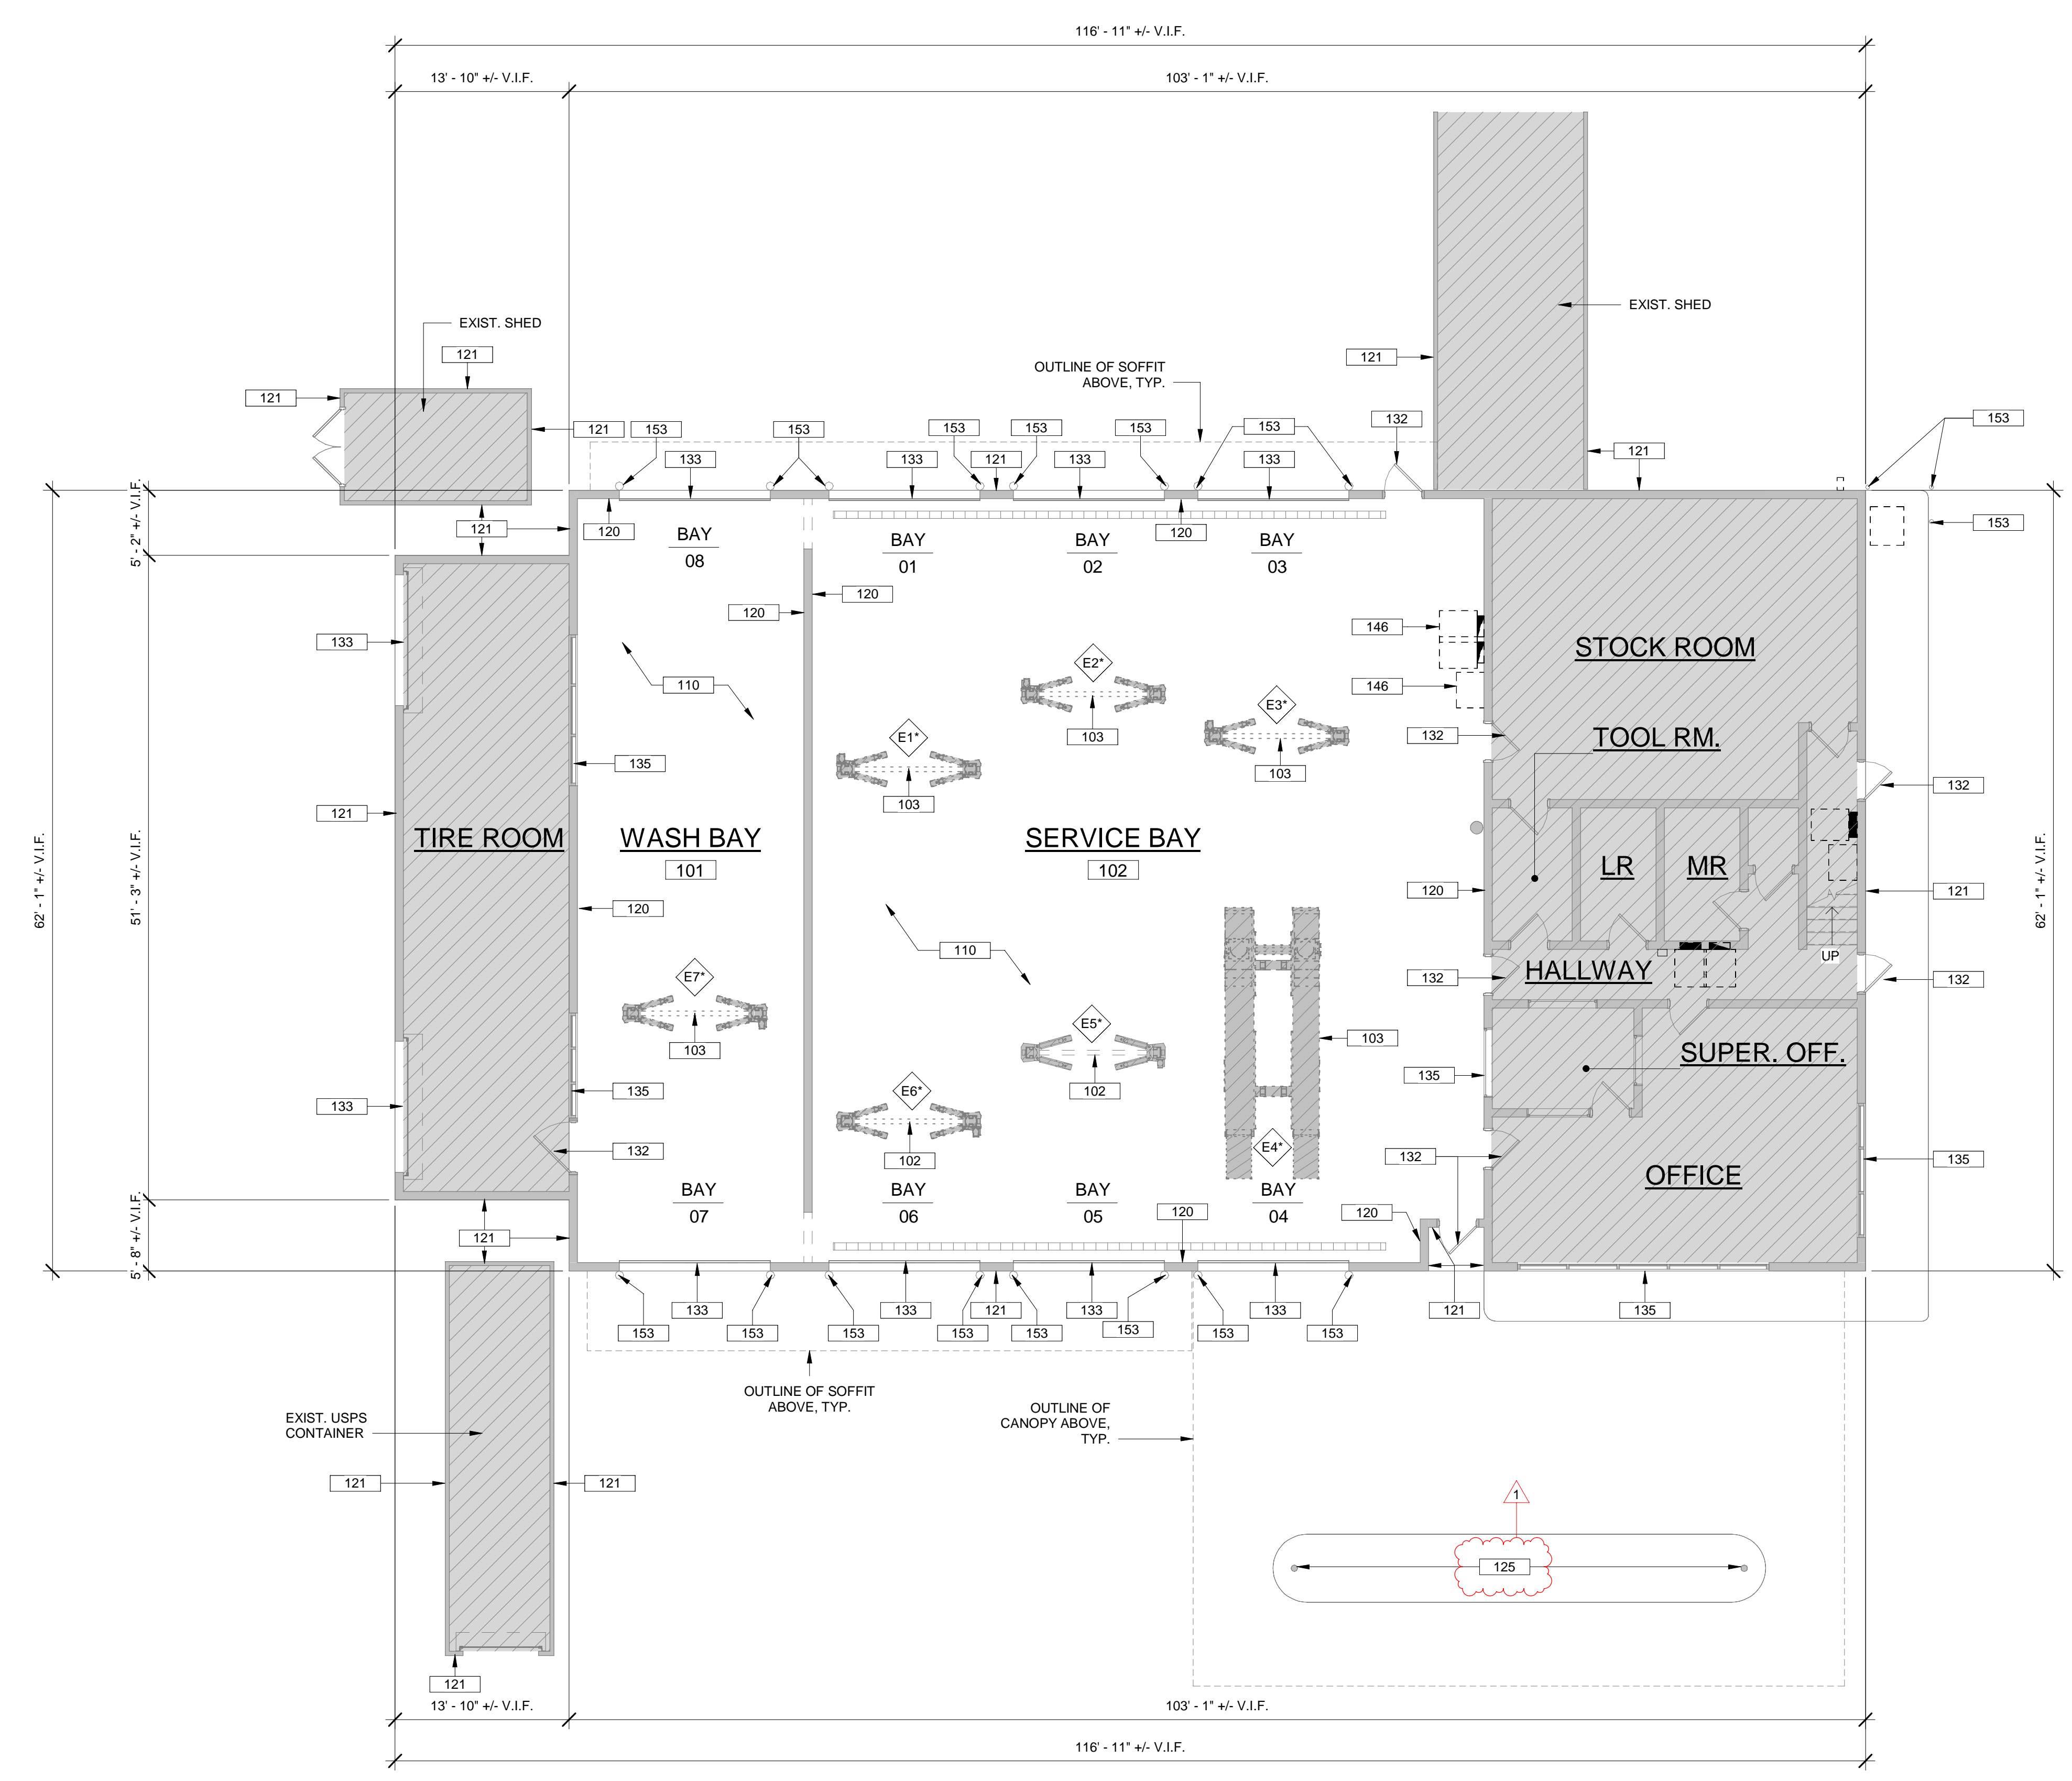

2 OVERALL MEZZANINE DEMOLITION PLAN

AD100 SCALE: 1/8" = 1'-0"

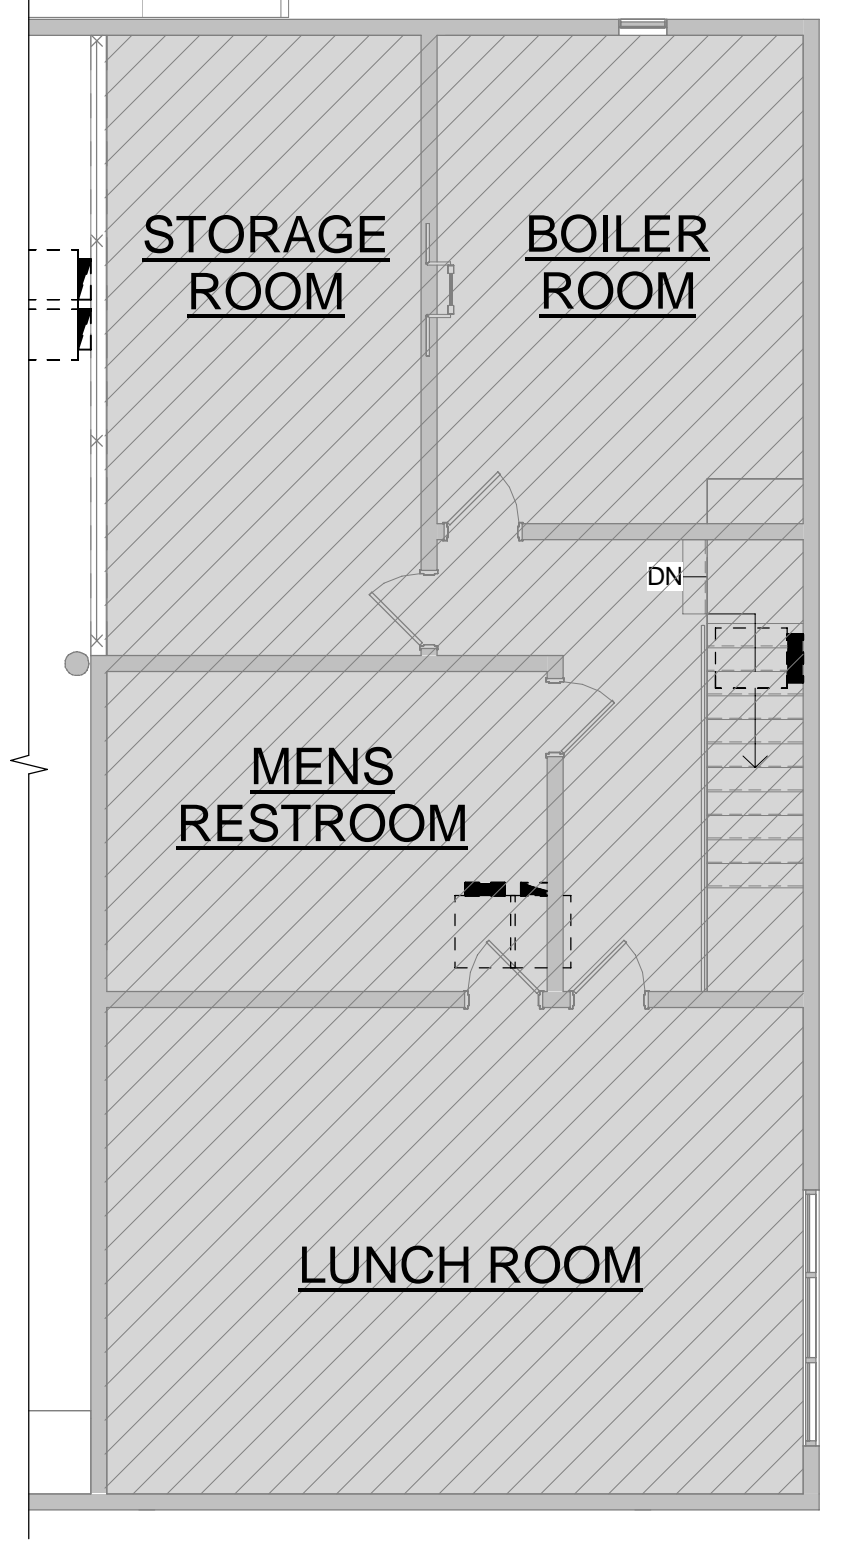

DEMO GENERAL NOTES



- ITEMS BELOW APPLY TO DASHED LINES AS INDICATED ON THE DEMOLITION PLAN UNLESS OTHERWISE NOTED.
- THE BUILDING AREAS ADJACENT TO THE AREA OF CONSTRUCTION WILL REMAIN OCCUPIED THROUGHOUT CONSTRUCTION. THE CONTRACTOR SHALL TAKE EVERY PRECAUTION FOR THE SAFETY AND PROTECTION OF ALL PERSONS IN THE BUILDING UNDER CONSTRUCTION FOR THE DURATION OF THE PROJECT.
 - EXISTING CONDITIONS ARE BASED ON INFORMATION OBTAINED FROM EXISTING DRAWINGS AND FIELD SURVEY AND SHALL NOT BE CONSTRUED AS "AS-BUILT." THE CONTRACTOR SHALL FIELD VERIFY ALL EXISTING CONDITIONS PRIOR TO CONSTRUCTION.
 - IN THE EVENT THAT QUESTIONABLE ENVIRONMENTAL MATERIALS ARE SUSPECTED OR IDENTIFIED BY THE CONTRACTOR, THE OWNER'S REPRESENTATIVE SHALL BE NOTIFIED IMMEDIATELY TO DETERMINE THE EXTENT OF MATERIAL AND THE COURSE OF ACTION.
 - ALL MECHANICAL, ELECTRICAL, PLUMBING, AND FIRE PROTECTION ELEMENTS WITHIN THE AREA OF DEMOLITION THAT ARE TO BE REMOVED, SHALL BE CUT AND CAPPED AND MADE SAFE BY A SUBCONTRACTOR TRADESMEN APPROPRIATE TO THE SCOPE PRIOR TO DEMOLITION AND REMOVAL WORK OCCURRING BY THE DEMOLITION SUBCONTRACTOR.
 - ALL DASHED PARTITIONS, WALL FURRING, SURFACE APPLIED MATERIALS OR FINISHES (I.E. WALL COVERINGS, WOOD PANELING, ETC.) PIPE AND CHASE FURRING IN INTERIOR SPACES AND AT PERIMETER WALLS SHALL BE REMOVED FULL HEIGHT INCLUDING DOORS AND FRAMES, ETC. WITHIN THE PARTITIONS.
 - REMOVE ALL FLOOR AND BASE MATERIALS AND MASTIC. PREPARE FLOOR AND WALL SURFACES TO RECEIVE NEW FLOOR AND BASE FINISH MATERIALS.
 - EXCEPT AS NOTED, REMOVE ALL CEILING SYSTEMS, INCLUDING, BUT NOT LIMITED TO:
 - A. ACOUSTICAL CEILING AND GRID SYSTEMS (SUSPENDED OR OTHERWISE), INCLUDING ALL SUPPORTING / SUSPENSION SYSTEMS.
 - B. SUSPENDED GYPSUM AND / OR PLASTER CEILING, INCLUDING ALL SUPPORTING / SUSPENSION SYSTEMS.
 - C. CEILING SYSTEMS ABOVE FINISHED / EXPOSED CEILING.
 - D. GYPSUM BOARD AND / OR PLASTER SOFFITS, CEILING RETURNS AND / OR DRAPERY POCKETS, ETC.
 - REMOVE ALL CASEWORK, EQUIPMENT, & MISCELLANEOUS ITEMS, INCLUDING BUT NOT LIMITED TO:
 - A. SHELVING BRACKETS, STANDARDS, CABINETS, COUNTERTOPS, UNISTRUT SUPPORTS, AND WALL ATTACHMENTS, ETC. UNLESS NOTED OTHERWISE.
 - OWNER HAS FIRST RIGHT OF SALVAGE TO ANY MATERIALS OR EQUIPMENT REMOVED UNDER THIS CONTRACT. OWNER WILL NOTIFY CONTRACTOR AS TO WHERE DESIGNATED AREA IS AVAILABLE FOR STORAGE OF SALVAGED ITEMS.
 - REQUIREMENTS OF STRUCTURAL WORK: DO NOT CUT STRUCTURAL WORK IN A MANNER RESULTING IN A REDUCTION OF LOAD-CARRYING CAPACITY OF LOAD/DEFLECTION RATIO.
 - OPERATIONAL AND SAFETY LIMITATIONS: DO NOT CUT OPERATIONAL ELEMENTS AND SAFETY-RELATED COMPONENTS IN A MANNER RESULTING IN A REDUCTION OF CAPACITIES TO PERFORM IN A MANNER INTENDED OR RESULTING IN A DECREASED OPERATIONAL LIFE, INCREASED MAINTENANCE, OR DECREASED SAFETY.
 - VISUAL REQUIREMENTS: DO NOT CUT WORK WHICH IS EXPOSED ON THE EXTERIOR OR EXPOSED IN OCCUPIED SPACES OF THE BUILDING IN A MANNER RESULTING IN A REDUCTION OF VISUAL QUALITIES OR RESULTING IN SUBSTANTIAL EVIDENCE OF THE DEMOLITION WORK JUDGED BY THE ARCHITECT TO BE CUT AND PATCHED IN A VISUALLY UNSATISFACTORY MANNER.
 - LOADING: DO NOT SUPERIMPOSE LOADS AT ANY POINT UPON EXISTING STRUCTURE BEYOND DESIGN CAPACITY INCLUDING LOADS ATTRIBUTABLE TO MATERIALS, CONSTRUCTION EQUIPMENT, DEMOLITION OPERATIONS AND SHORING AND BRACING.
 - VIBRATION: DO NOT USE MEANS, METHODS, TECHNIQUES, OR PROCEDURES WHICH WOULD INDUCE VIBRATION INTO ANY ELEMENT OF THE STRUCTURE.
 - FIRE: DO NOT USE MEANS, METHODS, TECHNIQUES, OR PROCEDURES WHICH WOULD PRODUCE ANY FIRE HAZARD UNLESS OTHERWISE APPROVED BY CONTRACTING OFFICER.
 - WATER: DO NOT USE MEANS, METHODS, TECHNIQUES, OR PROCEDURES WHICH WOULD PRODUCE EXCESSIVE WATER RUN-OFF, AND WATER POLLUTION.
 - AIR POLLUTION: DO NOT USE MEANS, METHODS, TECHNIQUES, OR PROCEDURES WHICH WOULD PRODUCE UNCONTROLLED DUST, FUMES, OR OTHER DAMAGING AIR POLLUTION.

KEYNOTES LEGEND - DEMO

MARK	DESCRIPTION
102	EXISTING LIFT TO REMAIN. NOT IN CONTRACT (N.I.C.)
103	EXISTING LIFT TO BE REPLACED/INSTALLED BY OTHERS (N.I.C.). PATCH AND REPAIR FLOOR AS REQUIRED. CONTRACTOR TO VERIFY SEQUENCE OF CONSTRUCTION.
110	EXISTING FLOOR FINISH TO BE REMOVED. CLEAN AND PREP EXISTING CONCRETE SUBSTRATE FOR NEW FLOOR FINISH. PATCH AND REPAIR SURFACE AS REQUIRED. PRESSURE WASH/CLEAN EXISTING TRENCH DRAINS AND COVER PLATES AS REQUIRED. PREPARE EXISTING STRIPED CIRCULATION AREAS TO RECEIVE NEW FINISH.
120	PREPARE INTERIOR WALL SURFACES AND ASSOCIATED EXISTING LOUVERS TO RECEIVE NEW FINISH. CLEAN, PREP, AND PATCH/REPAIR AS REQUIRED. CONTRACTOR TO VERIFY QUANTITY OF LOUVERS.
121	PRESSURE WASH EXTERIOR WALL SURFACES. PREPARE EXISTING LOUVERS TO RECEIVE NEW FINISH. CLEAN, PREP, AND PATCH/REPAIR AS REQUIRED. CONTRACTOR TO VERIFY QUANTITY OF LOUVERS.
125	PRESSURE WASH/CLEAN EXISTING CANOPY STRUCTURE. PATCH/REPAIR SURFACE AS REQUIRED.
132	PREPARE EXISTING DOOR AND FRAME TO RECEIVE NEW FINISH. CLEAN, PREP, AND PRIME AS REQUIRED. TYP.
133	WASH/CLEAN INTERIOR AND EXTERIOR OF EXISTING OVERHEAD SECTIONAL DOOR AND FRAME ASSEMBLY. TYP.
135	WASH/CLEAN INTERIOR AND EXTERIOR OF EXISTING WINDOW AND FRAME ASSEMBLY. TYP.
146	EXISTING ELECTRICAL EQUIPMENT. REFER TO ELECTRICAL DRAWINGS FOR SCOPE.
153	PREPARE EXISTING BOLLARD TO RECEIVE NEW FINISH. CLEAN, PREP, AND PATCH/REPAIR AS REQUIRED. TYP.

LEGEND

- NOT IN SCOPE
- INDICATES ELEMENTS TO BE DEMO'D. SEE KEYNOTES FOR DETAILS
- LIFT TAG
 - E# INDICATES EXISTING LIFTS
 - N# INDICATES LIFTS NOT IN SCOPE

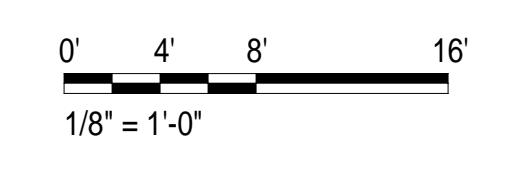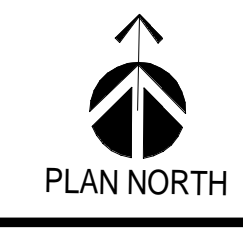

AD100 OVERALL FIRST FLOOR & MEZZANINE DEMOLITION PLAN

Scale: AS NOTED Date: Jan 12, 2024 Project: LYNWOOD (NORTH) USPS File Number: E0879

90% DESIGN SUBMITTAL

Revisions: 02/02/2024 Revision 1

UNITED STATES POSTAL SERVICE

LYNWOOD (NORTH) 6821 208TH ST SW LYNWOOD, WA 98036


WSP USA INC. 2711 BROADWAY ST. LOUIS, MO 63102




Copyright 2006-2013, United States Postal Service

DATE & TIME: 2/5/2024 4:34:05 PM

1 OVERALL FIRST FLOOR DEMOLITION REFLECTED CEILING PLAN
 AD150 SCALE: 1/8" = 1'-0"

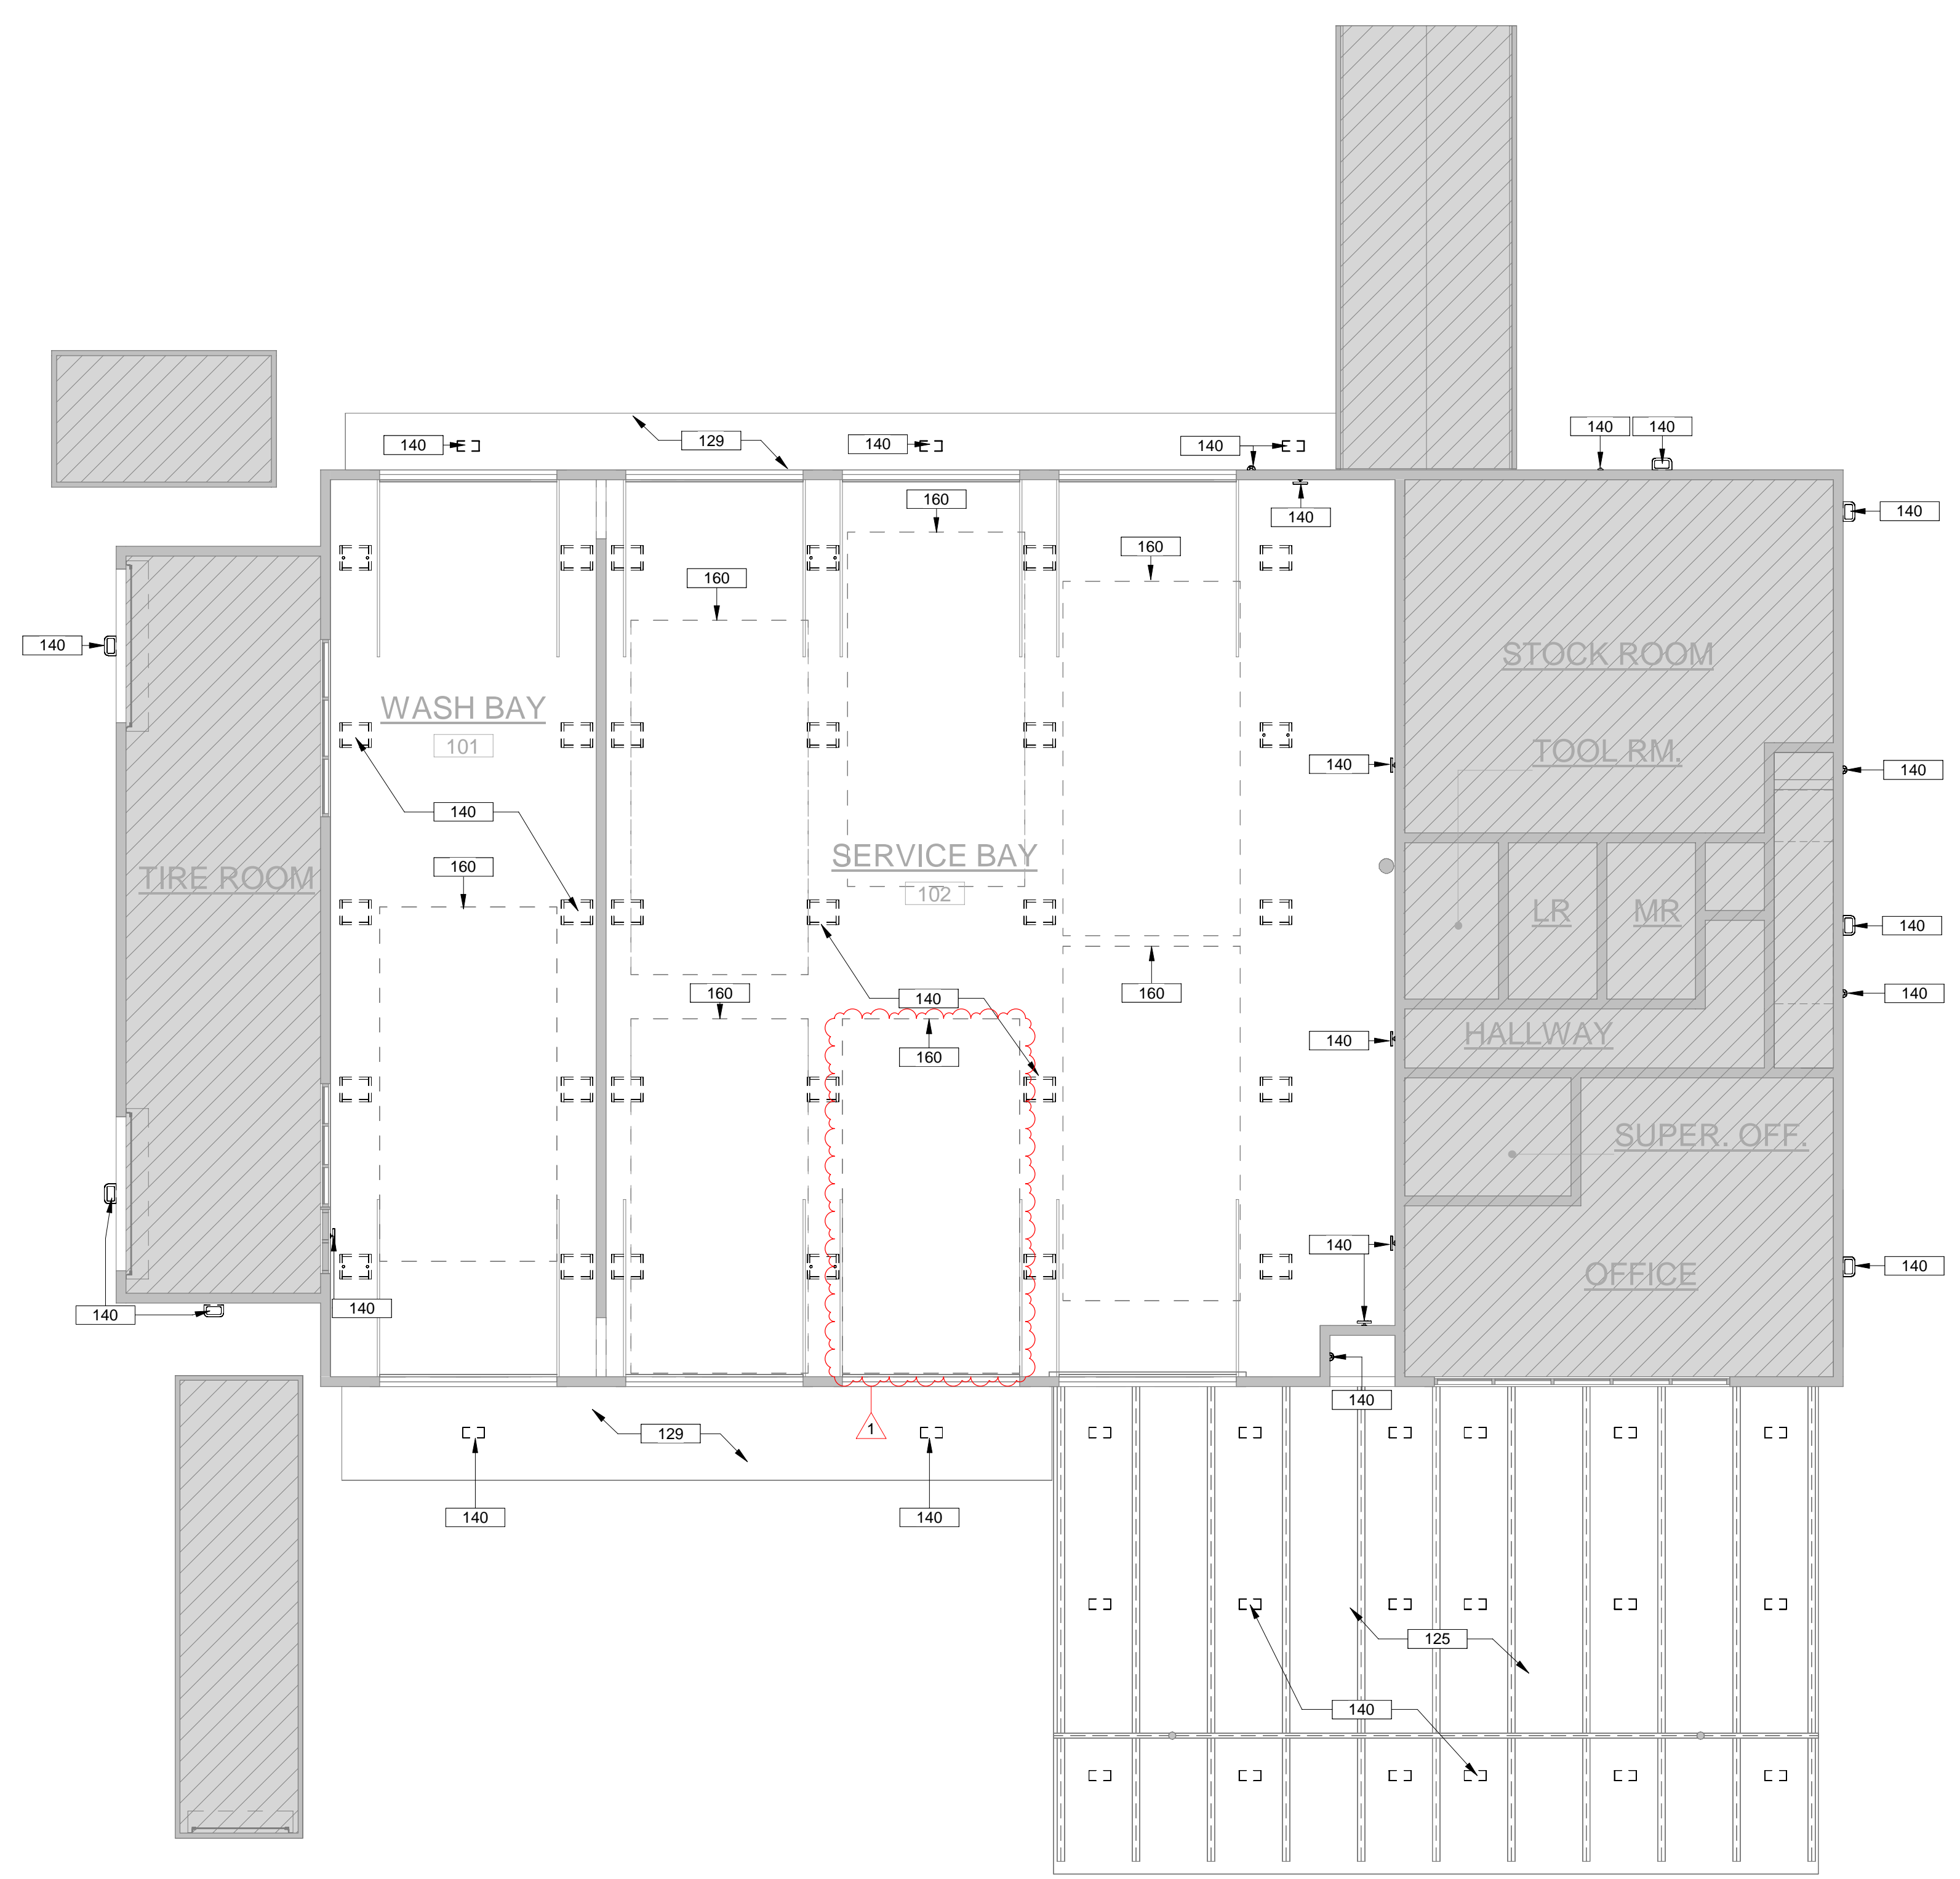

2 OVERALL MEZZANINE DEMOLITION REFLECTED CEILING PLAN
 AD150 SCALE: 1/8" = 1'-0"

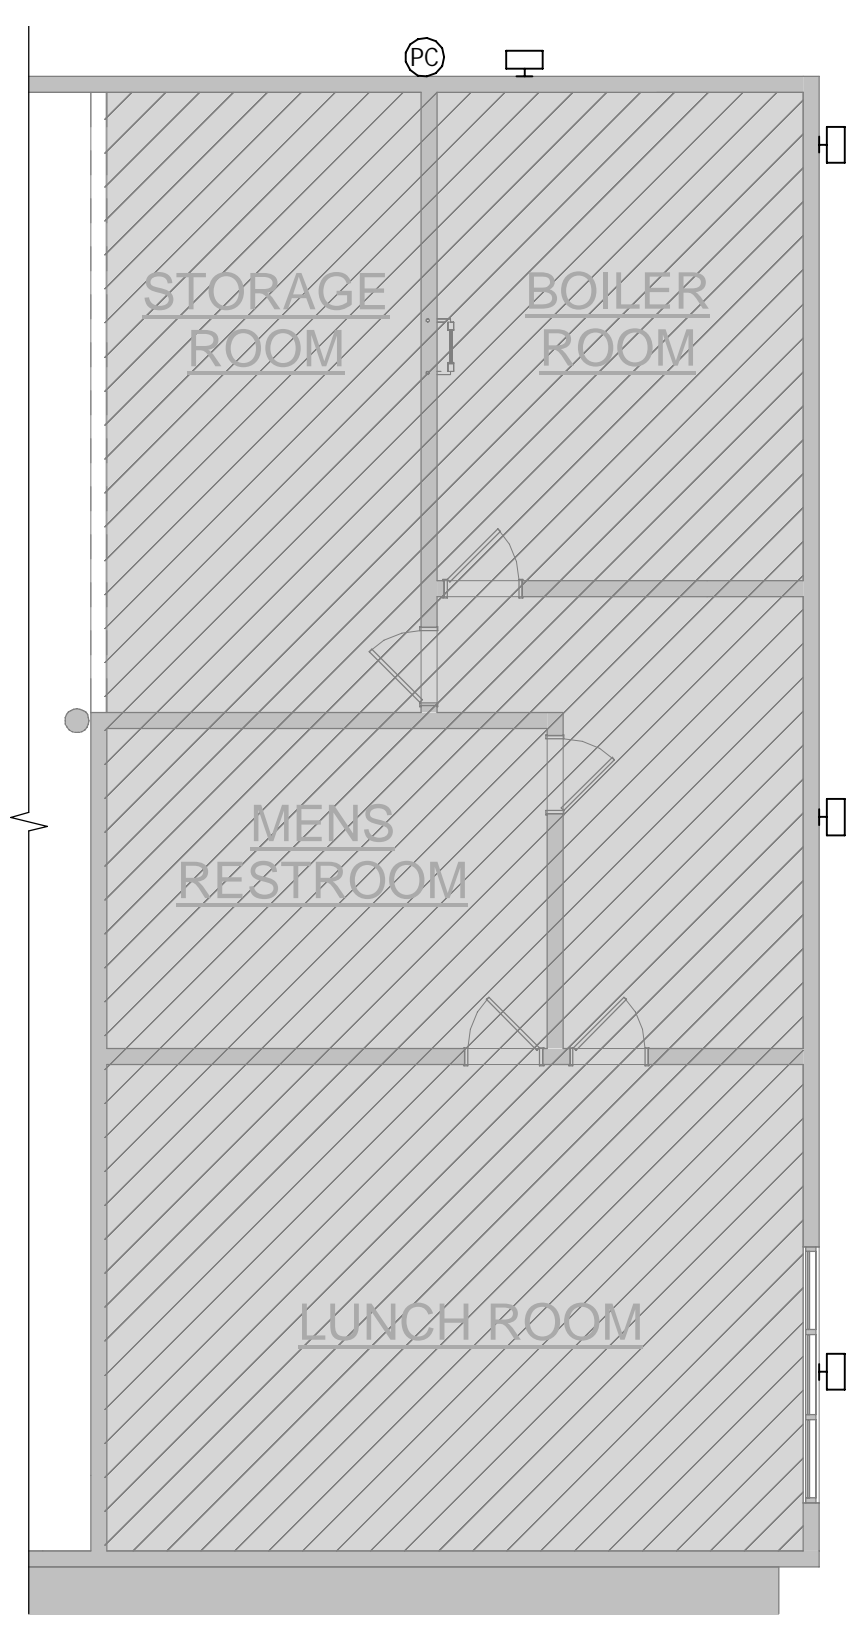

DEMO GENERAL NOTES

- ITEMS BELOW APPLY TO DASHED LINES AS INDICATED ON THE DEMOLITION PLAN UNLESS OTHERWISE NOTED.
- THE BUILDING AREAS ADJACENT TO THE AREA OF CONSTRUCTION WILL REMAIN OCCUPIED THROUGHOUT CONSTRUCTION. THE CONTRACTOR SHALL TAKE EVERY PRECAUTION FOR THE SAFETY AND PROTECTION OF ALL PERSONS IN THE BUILDING UNDER CONSTRUCTION FOR THE DURATION OF THE PROJECT.
 - EXISTING CONDITIONS ARE BASED ON INFORMATION OBTAINED FROM EXISTING DRAWINGS AND FIELD SURVEY AND SHALL NOT BE CONSTRUED AS "AS-BUILT." THE CONTRACTOR SHALL FIELD VERIFY ALL EXISTING CONDITIONS PRIOR TO CONSTRUCTION.
 - IN THE EVENT THAT QUESTIONABLE ENVIRONMENTAL MATERIALS ARE SUSPECTED OR IDENTIFIED BY THE CONTRACTOR, THE OWNER'S REPRESENTATIVE SHALL BE NOTIFIED IMMEDIATELY TO DETERMINE THE EXTENT OF MATERIAL AND THE COURSE OF ACTION.
 - ALL MECHANICAL, ELECTRICAL, PLUMBING, AND FIRE PROTECTION ELEMENTS WITHIN THE AREA OF DEMOLITION THAT ARE TO BE REMOVED, SHALL BE CUT AND CAPPED AND MADE SAFE BY A SUBCONTRACTOR TRADESMAN APPROPRIATE TO THE SCOPE PRIOR TO DEMOLITION AND REMOVAL WORK OCCURRING BY THE DEMOLITION SUBCONTRACTOR.
 - ALL DASHED PARTITIONS, WALL FURRING, SURFACE APPLIED MATERIALS OR FINISHES (I.E. WALL COVERINGS, WOOD PANELING, ETC.) PIPE AND CHASE FURRING IN INTERIOR SPACES AND AT PERIMETER WALLS SHALL BE REMOVED FULL HEIGHT INCLUDING DOORS AND FRAMES, ETC. WITHIN THE PARTITIONS.
 - REMOVE ALL FLOOR AND BASE MATERIALS AND MASTIC. PREPARE FLOOR AND WALL SURFACES TO RECEIVE NEW FLOOR AND BASE FINISH MATERIALS.
 - EXCEPT AS NOTED, REMOVE ALL CEILING SYSTEMS, INCLUDING, BUT NOT LIMITED TO:
 - ACOUSTICAL CEILING AND GRID SYSTEMS (SUSPENDED OR OTHERWISE), INCLUDING ALL SUPPORTING / SUSPENSION SYSTEMS.
 - SUSPENDED GYPSUM AND / OR PLASTER CEILING, INCLUDING ALL SUPPORTING / SUSPENSION SYSTEMS.
 - CEILING SYSTEMS ABOVE FINISHED / EXPOSED CEILING.
 - GYPSUM BOARD AND / OR PLASTER SOFFITS, CEILING RETURNS AND / OR DRAPERY POCKETS, ETC.
 - REMOVE ALL CASEWORK, EQUIPMENT, & MISCELLANEOUS ITEMS, INCLUDING BUT NOT LIMITED TO:
 - SHELVING BRACKETS, STANDARDS, CABINETS, COUNTERTOPS, UNISTRUT SUPPORTS, AND WALL ATTACHMENTS, ETC. UNLESS NOTED OTHERWISE.
 - OWNER HAS FIRST RIGHT OF SALVAGE TO ANY MATERIALS OR EQUIPMENT REMOVED UNDER THIS CONTRACT. OWNER WILL NOTIFY CONTRACTOR AS TO WHERE DESIGNATED AREA IS AVAILABLE FOR STORAGE OF SALVAGED ITEMS.
 - REQUIREMENTS OF STRUCTURAL WORK: DO NOT CUT STRUCTURAL WORK IN A MANNER RESULTING IN A REDUCTION OF LOAD-CARRYING CAPACITY OF LOAD/DEFLECTION RATIO.
 - OPERATIONAL AND SAFETY LIMITATIONS: DO NOT CUT OPERATIONAL ELEMENTS AND SAFETY-RELATED COMPONENTS IN A MANNER RESULTING IN A REDUCTION OF CAPACITIES TO PERFORM IN A MANNER INTENDED OR RESULTING IN A DECREASED OPERATIONAL LIFE, INCREASED MAINTENANCE, OR DECREASED SAFETY.
 - VISUAL REQUIREMENTS: DO NOT CUT WORK WHICH IS EXPOSED ON THE EXTERIOR OR EXPOSED IN OCCUPIED SPACES OF THE BUILDING IN A MANNER RESULTING IN A REDUCTION OF VISUAL QUALITIES OR RESULTING IN SUBSTANTIAL EVIDENCE OF THE DEMOLITION WORK JUDGED BY THE ARCHITECT TO BE CUT AND PATCHED IN A VISUALLY UNSATISFACTORY MANNER.
 - LOADING: DO NOT SUPERIMPOSE LOADS AT ANY POINT UPON EXISTING STRUCTURE BEYOND DESIGN CAPACITY INCLUDING LOADS ATTRIBUTABLE TO MATERIALS, CONSTRUCTION EQUIPMENT, DEMOLITION OPERATIONS AND SHORING AND BRACING.
 - VIBRATION: DO NOT USE MEANS, METHODS, TECHNIQUES, OR PROCEDURES WHICH WOULD INDUCE VIBRATION INTO ANY ELEMENT OF THE STRUCTURE.
 - FIRE: DO NOT USE MEANS, METHODS, TECHNIQUES, OR PROCEDURES WHICH WOULD PRODUCE ANY FIRE HAZARD UNLESS OTHERWISE APPROVED BY CONTRACTING OFFICER.
 - WATER: DO NOT USE MEANS, METHODS, TECHNIQUES, OR PROCEDURES WHICH WOULD PRODUCE EXCESSIVE WATER RUN-OFF, AND WATER POLLUTION.
 - AIR POLLUTION: DO NOT USE MEANS, METHODS, TECHNIQUES, OR PROCEDURES WHICH WOULD PRODUCE UNCONTROLLED DUST, FUMES, OR OTHER DAMAGING AIR POLLUTION.

KEYNOTES LEGEND - DEMO

MARK	DESCRIPTION
125	PRESSURE WASH/CLEAN EXISTING CANOPY STRUCTURE: PATCH/REPAIR SURFACE AS REQUIRED.
129	PRESSURE WASH/CLEAN OVERHANG: PREPARE EXISTING SOFFIT TO RECEIVE NEW FINISH: PATCH/REPAIR SURFACE AS REQUIRED.
140	EXISTING LIGHT FIXTURES/ELECTRICAL EQUIPMENT AND ALL RELATED HARDWARE TO BE REMOVED. CONTRACTOR TO VERIFY EXISTING FIXTURE QUANTITY. REFER TO ELECTRICAL DRAWINGS FOR ADDITIONAL INFORMATION.
160	ALL UTILITIES, FIXTURES, MECHANICAL SYSTEMS OR ANY OBSTRUCTIONS WITHIN LIFT SERVICE AREAS SHALL BE RELOCATED ABOVE 15' - 3" A.F.F.

LEGEND

NOT IN SCOPE

INDICATES ELEMENTS TO BE DEMOLISHED. SEE KEYNOTES FOR DETAILS



OVERALL FIRST FLOOR & MEZZANINE DEMOLITION REFLECTED CEILING PLAN
 AD150 Scale: AS NOTED Date: Jan 12, 2024
 Project: LYNNWOOD (NORTH)
 USFS File Number: E88779

90% DESIGN SUBMITTAL
 02/02/2024
 Revision 1

UNITED STATES POSTAL SERVICE

LYNNWOOD (NORTH)
 6821 208TH ST SW
 LYNNWOOD, WA 98036

WSP USA INC.
 2711 BROADWAY
 ST. LOUIS, MO 63102


WSP

KORTE


Copyright 2006-2013, United States Postal Service

DATE & TIME: 2/5/2024 4:34:01 PM

1 OVERALL PROPOSED FIRST FLOOR PLAN
 A100 SCALE: 1/8" = 1'-0"

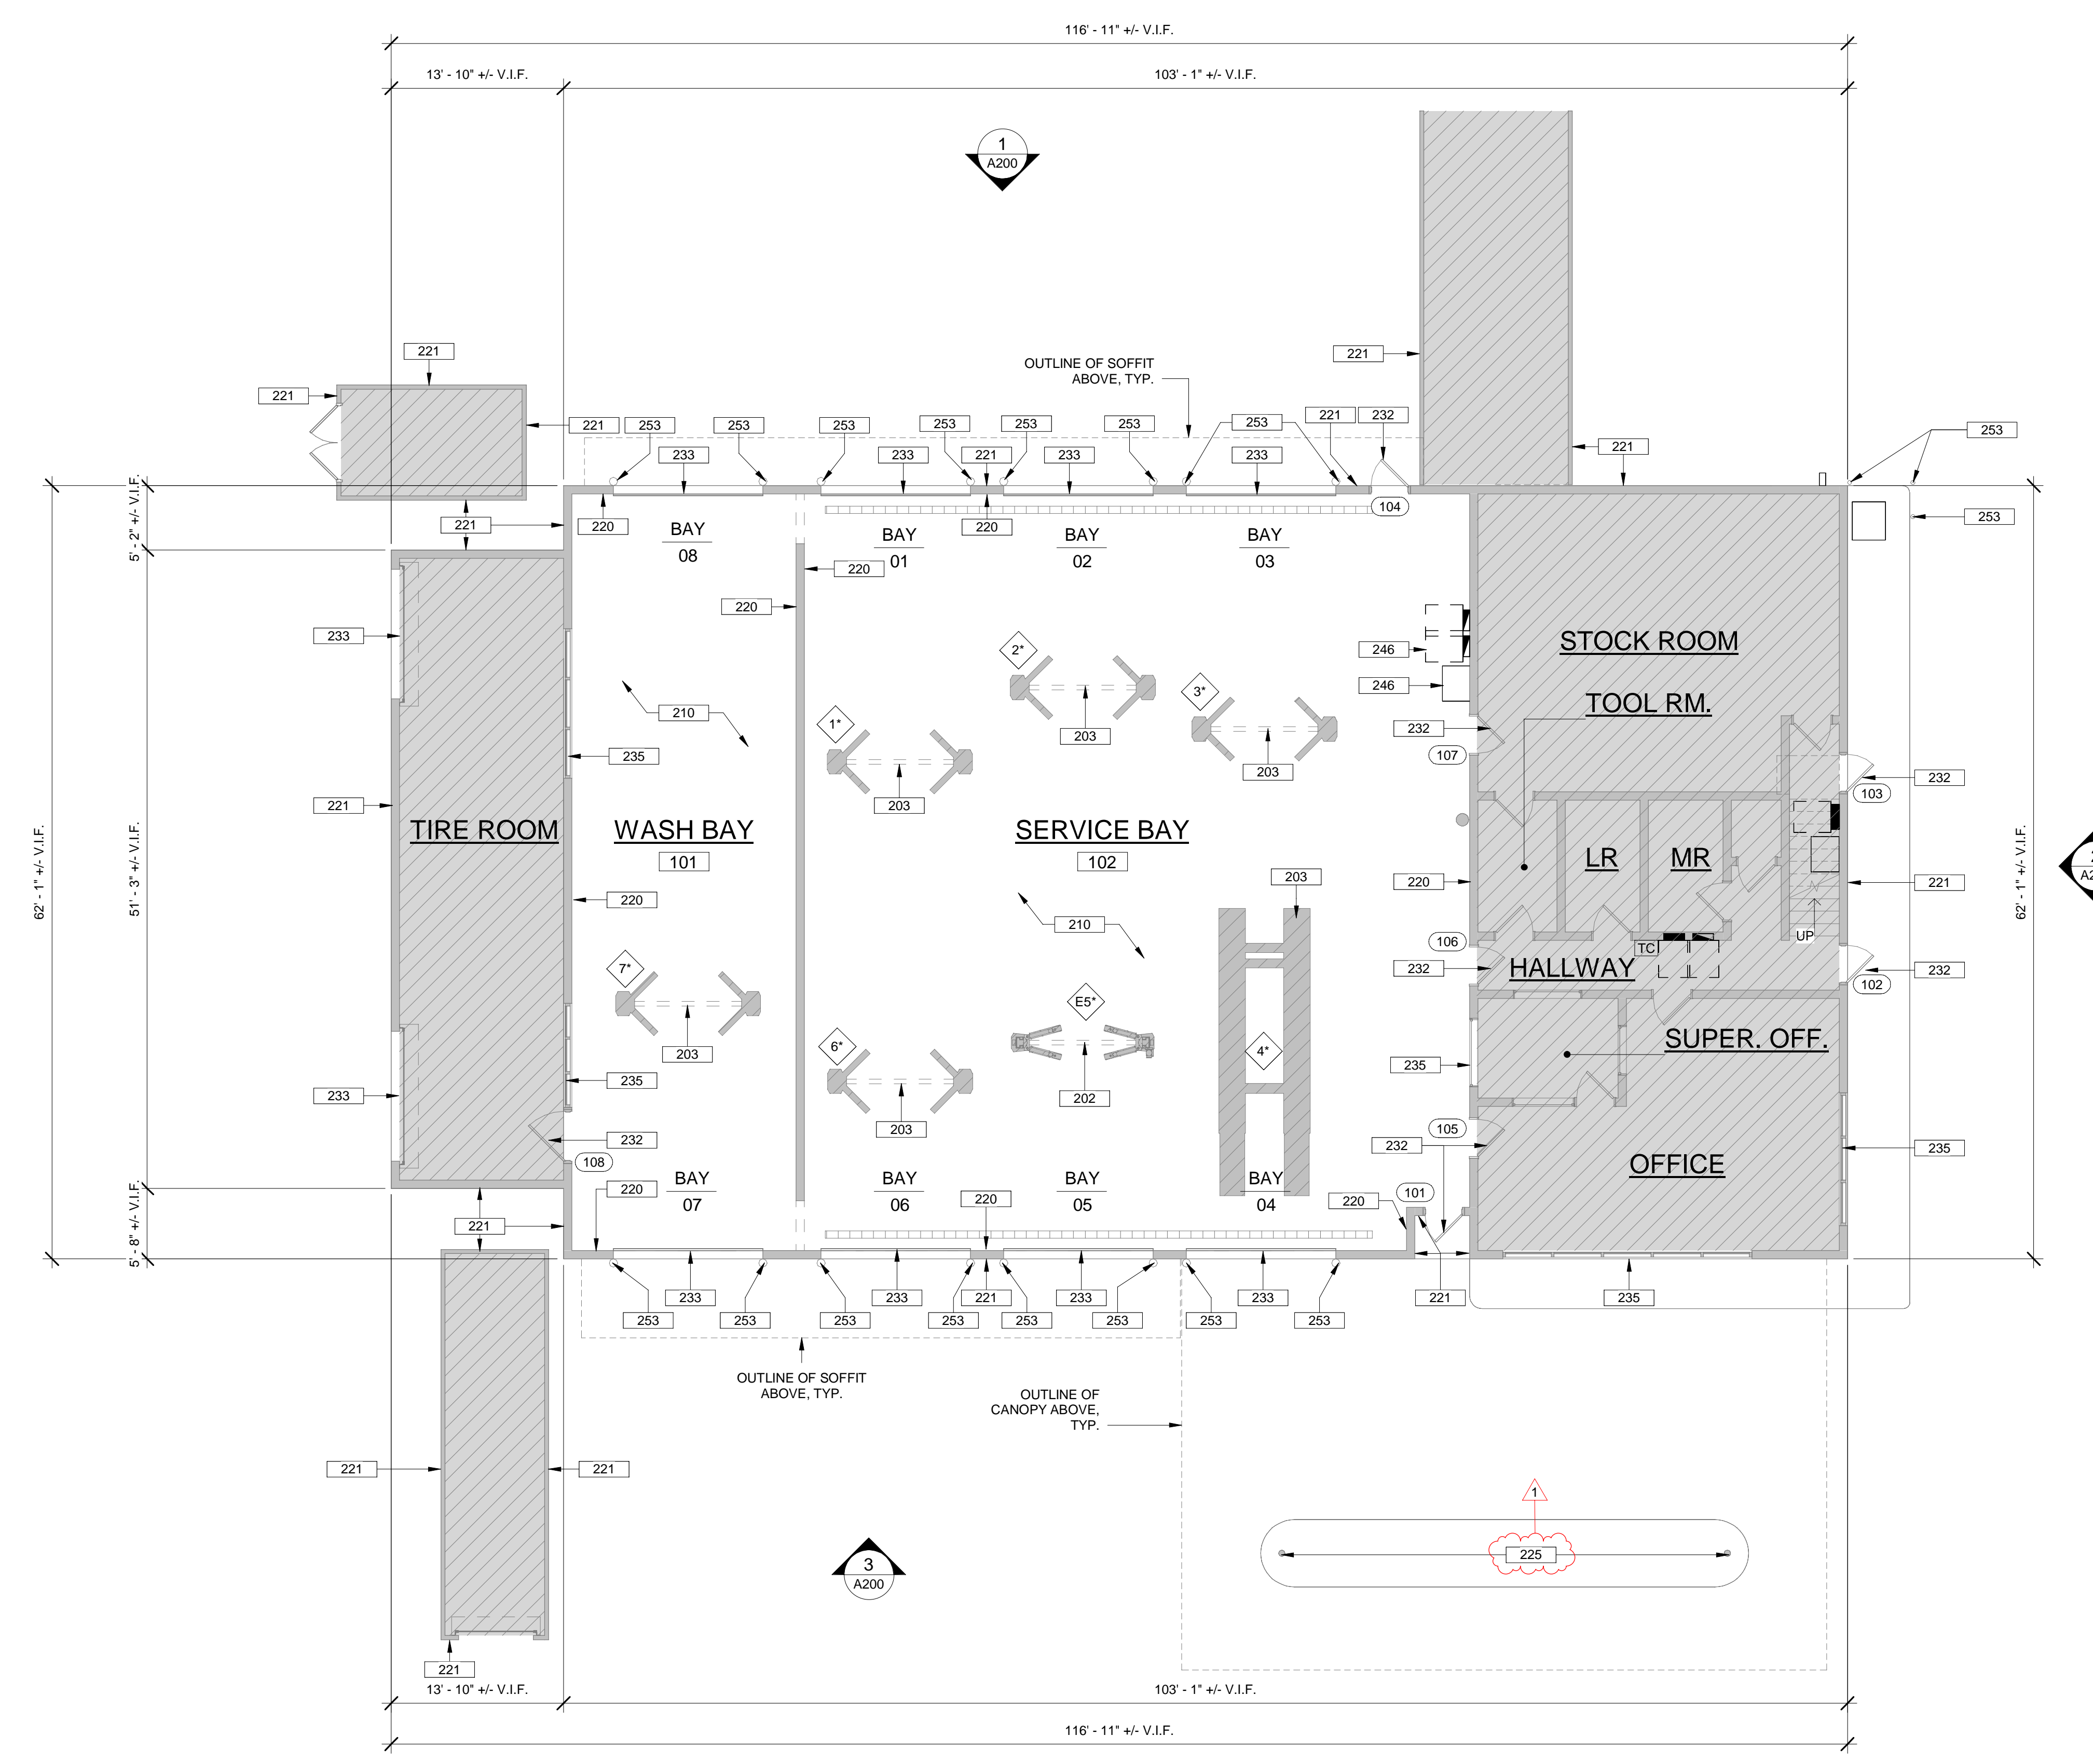

2 OVERALL PROPOSED MEZZANINE PLAN
 A100 SCALE: 1/8" = 1'-0"

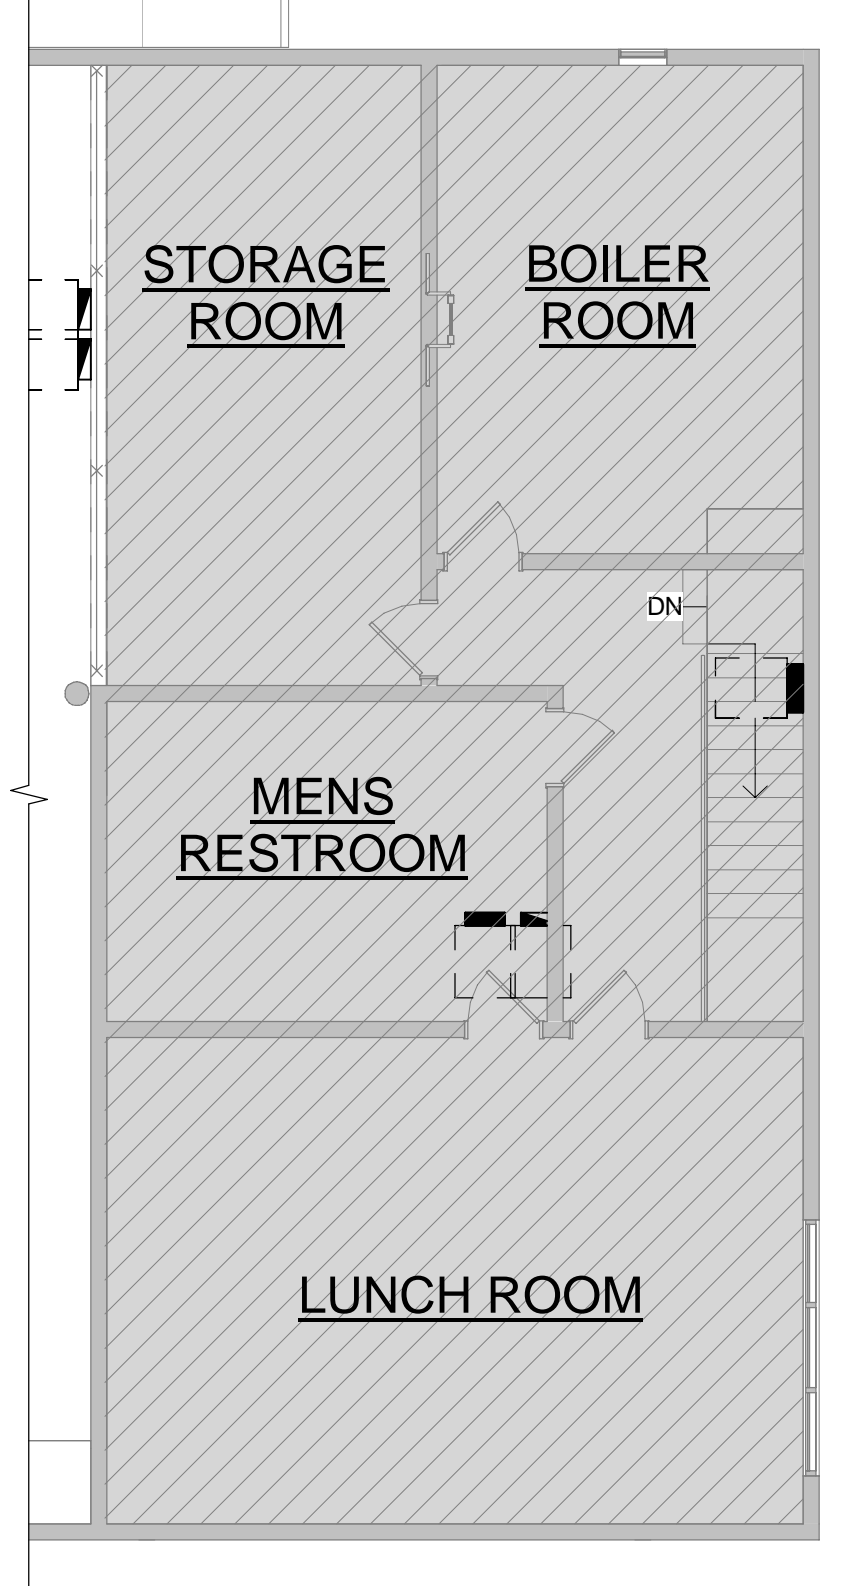


GENERAL NOTES

REFER TO G.002 FOR GENERAL NOTES

KEYNOTES LEGEND	
MARK	DESCRIPTION
202	EXISTING LIFT TO REMAIN. NOT IN CONTRACT (N.I.C.)
203	EXISTING LIFT TO BE REPLACED/INSTALLED BY OTHERS (N.I.C.). PATCH AND REPAIR FLOOR AS REQUIRED. CONTRACTOR TO VERIFY SEQUENCE OF CONSTRUCTION.
210	INSTALL NEW FLOOR SURFACE. CLEAN AND PREPARE EXISTING SUBSTRATE FOR NEW FLOOR FINISH. PRESSURE WASH/CLEAN EXISTING TRENCH DRAINS AND COVER PLATES AS REQUIRED. REPAINT STRIPED CIRCULATION AREAS TO MATCH EXISTING.
220	PAINT INTERIOR WALL SURFACES AND ASSOCIATED EXISTING LOUVERS. CLEAN, PREP, AND PRIME AS REQUIRED FOR NEW PAINT. TYP. U.N.O.; CONTRACTOR TO VERIFY LOUVER QUANTITY. LOUVER COLOR TO MATCH WALL COLOR. REFER TO FINISH SCHEDULE FOR ADDITIONAL INFORMATION.
221	POWER WASH EXTERIOR WALL SURFACES. PAINT EXTERIOR LOUVERS. CLEAN, PREP, AND PRIME AS REQUIRED FOR NEW PAINT. LOUVER COLOR TO MATCH EXISTING. CONTRACTOR TO VERIFY QUANTITY OF LOUVERS.
225	PRESSURE WASH/CLEAN EXISTING CANOPY STRUCTURE. PATCH/REPAIR SURFACE AS REQUIRED.
232	EXISTING DOOR AND FRAME TO BE PAINTED. CLEAN, PREP AND PRIME AS REQUIRED FOR NEW FINISH. PAINT ALL SIDES AND EDGES OF DOOR/FRAME. REFER TO FINISH SCHEDULE FOR ADDITIONAL INFORMATION. TYP.
233	WASH/CLEAN INTERIOR AND EXTERIOR OF EXISTING OVERHEAD SECTIONAL DOOR AND FRAME ASSEMBLY. TYP.
235	WASH/CLEAN INTERIOR AND EXTERIOR OF EXISTING WINDOW AND FRAME ASSEMBLY. TYP.
246	EXISTING ELECTRICAL EQUIPMENT. REFER TO ELECTRICAL DRAWINGS FOR SCOPE.
253	PAINT EXISTING BOLLARD SAFETY YELLOW TO COMPLY WITH USPS STANDARDS. CLEAN, PREP AND PRIME AS REQUIRED FOR NEW FINISH. TYP.

LEGEND


	NOT IN SCOPE
	LIFT TAG
E#	INDICATES EXISTING LIFTS
#	INDICATES LIFTS NOT IN SCOPE

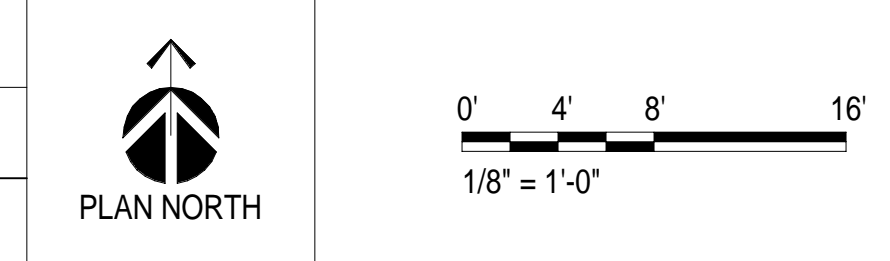

DATE & TIME: 2/5/2024 4:34:02 PM

1 OVERALL PROPOSED FIRST FLOOR REFLECTED CEILING PLAN

A150 SCALE: 1/8" = 1'-0"

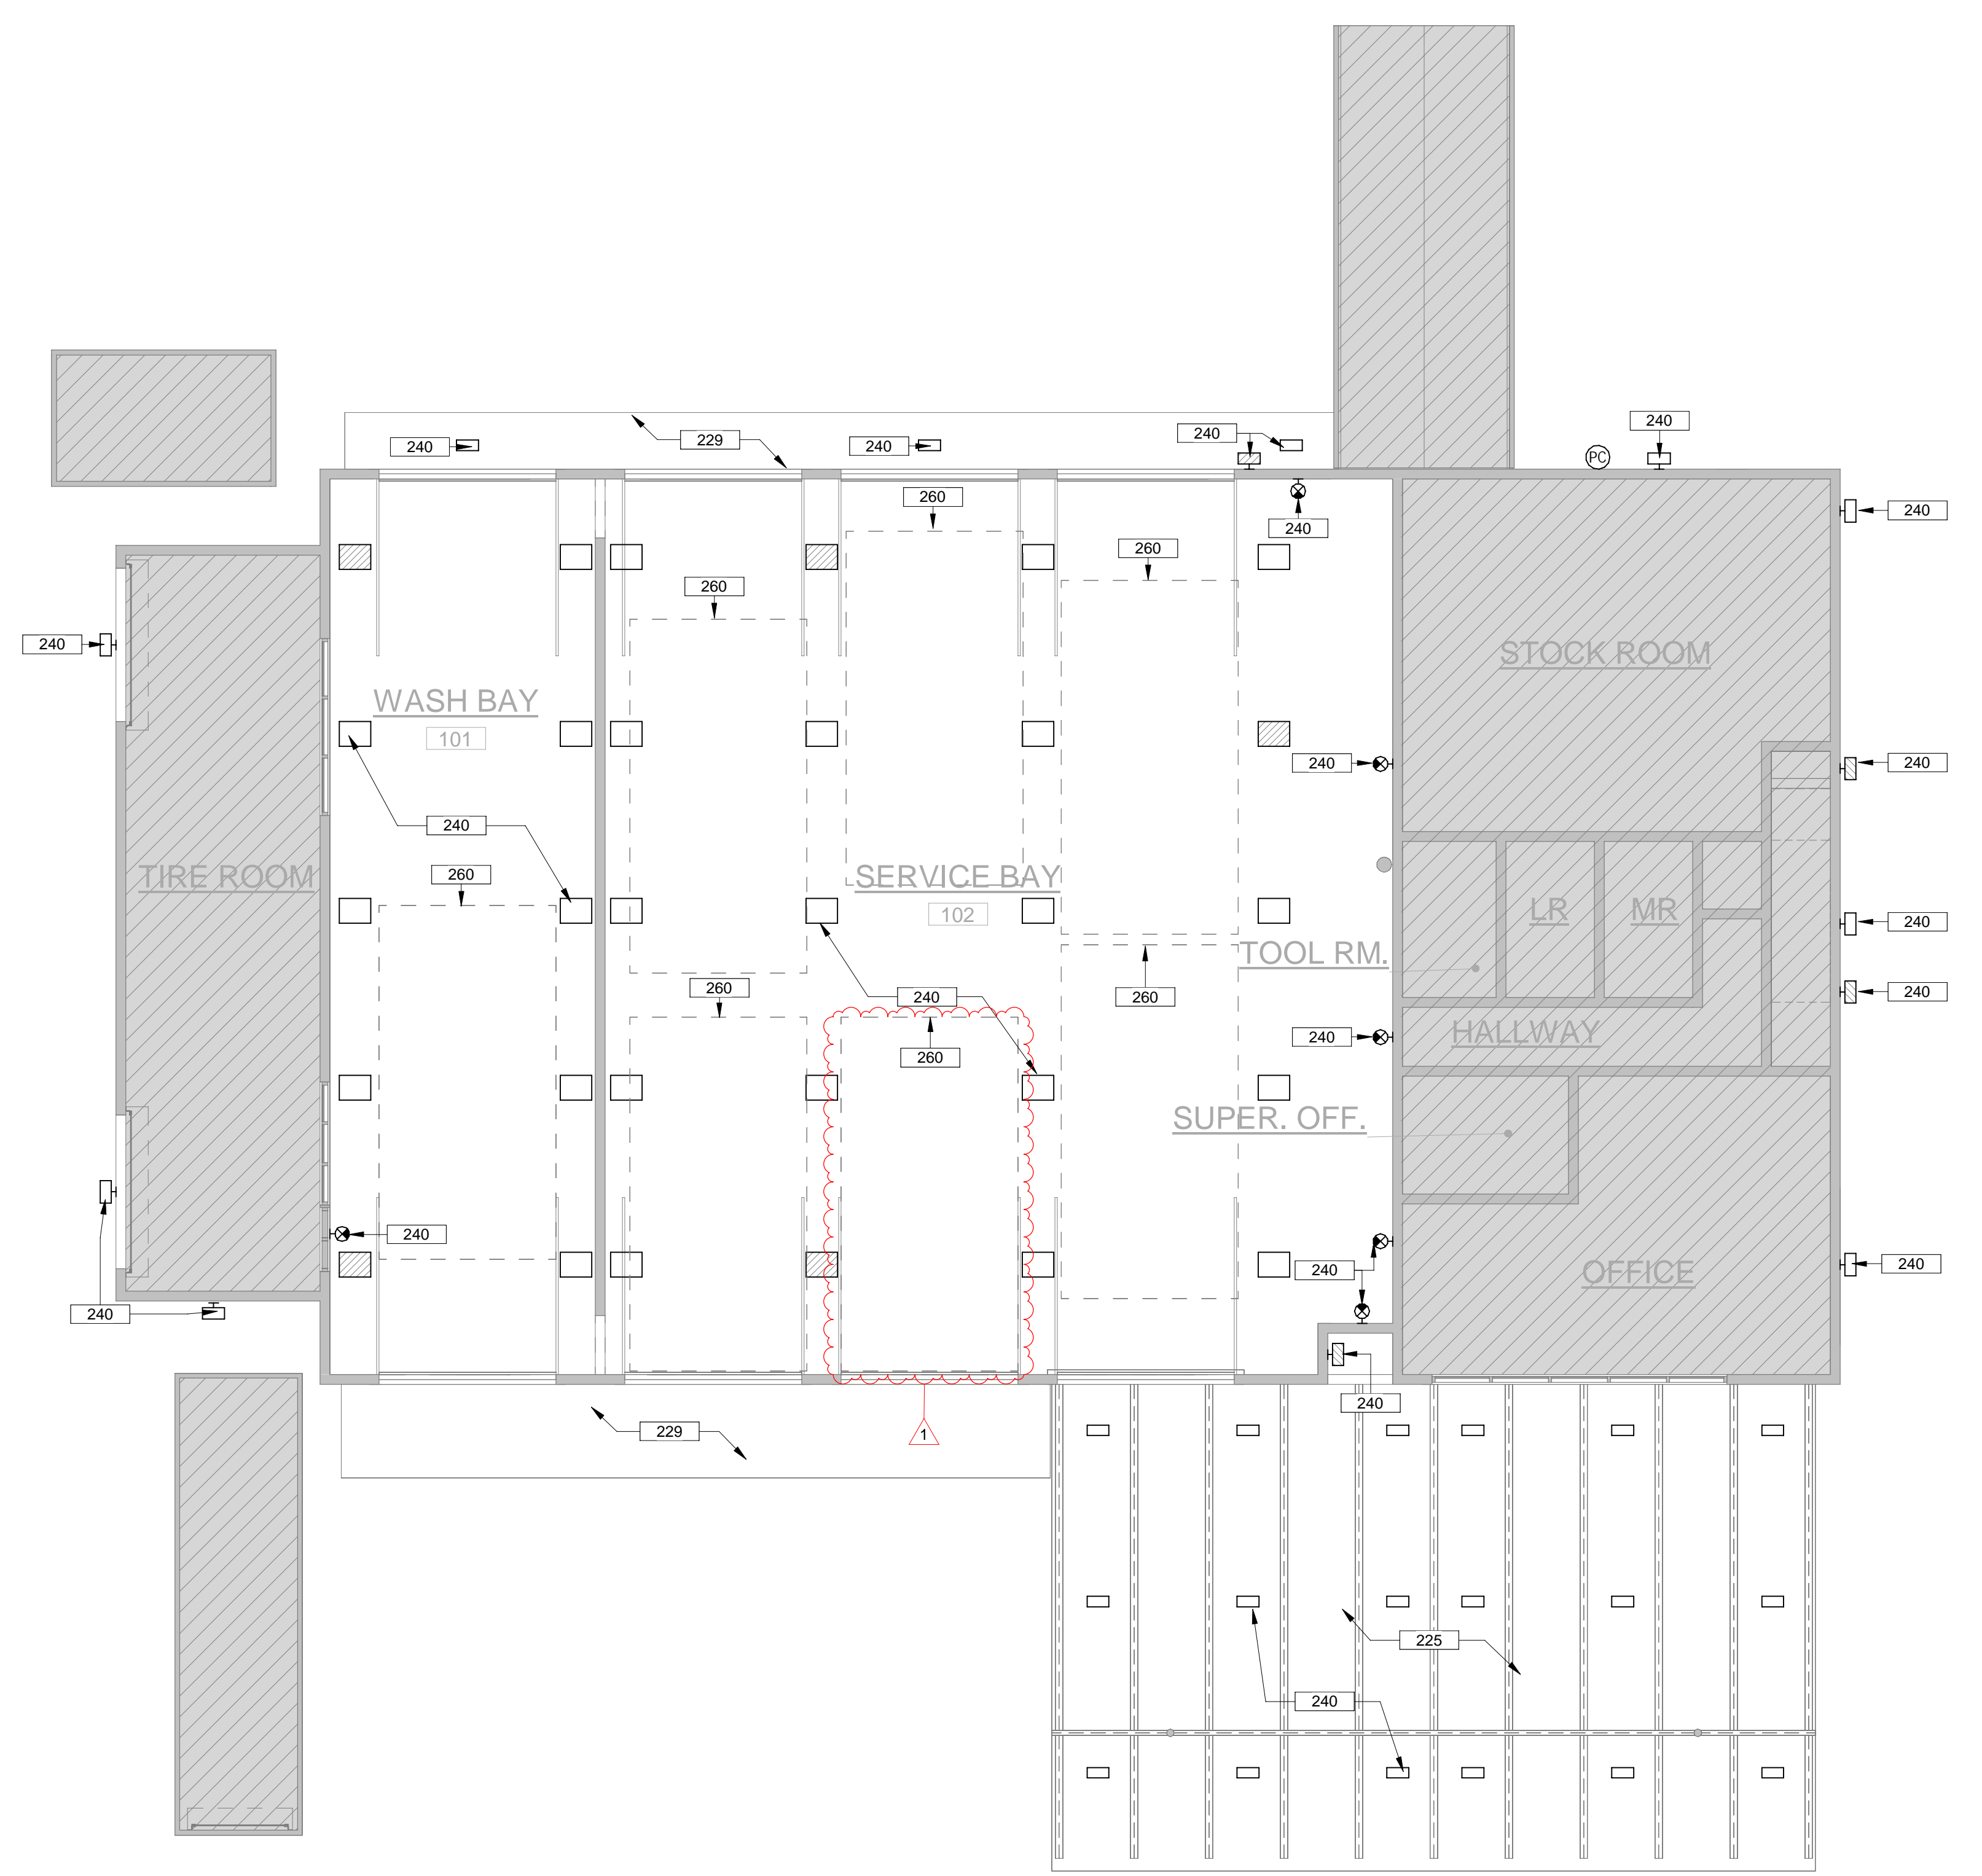



GENERAL NOTES

REFER TO G.002 FOR GENERAL NOTES

KEYNOTES LEGEND	
MARK	DESCRIPTION
225	PRESSURE WASH/CLEAN EXISTING CANOPY STRUCTURE; PATCH/REPAIR SURFACE AS REQUIRED.
229	PRESSURE WASH/CLEAN OVERHANG; PAINT EXISTING SOFFIT; CLEAN, PREP, AND PRIME SURFACE TO RECEIVE NEW FINISH COLOR TO MATCH EXISTING.
240	NEW LIGHT FIXTURE ASSEMBLY/ELECTRICAL EQUIPMENT; TYP. REFER TO ELECTRICAL DRAWINGS FOR ADDITIONAL INFORMATION.
260	ALL UTILITIES, FIXTURES, MECHANICAL SYSTEMS OR ANY OBSTRUCTIONS WITHIN LIFT SERVICE AREAS SHALL BE RELOCATED ABOVE 15' - 3" A.F.F.

LEGEND

NOT IN SCOPE

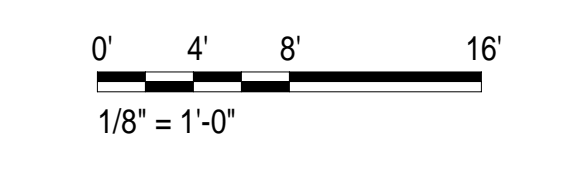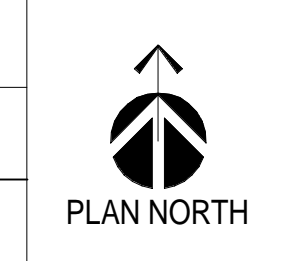


WSP USA INC.
 2718 BROADWAY
 ST. LOUIS, MO 63102

Copyright 2006-2013, United States Postal Service


WSP
KORTE
built smart.

UNITED STATES POSTAL SERVICE
 LYNNWOOD (NORTH)
 6821 208TH ST SW
 LYNNWOOD, WA 98036


OVERALL PROPOSED FIRST FLOOR & MEZZ. FLOOR PLAN
 90% DESIGN SUBMITTAL
 Date: Jan 12, 2024
 Revision 1
 E8879

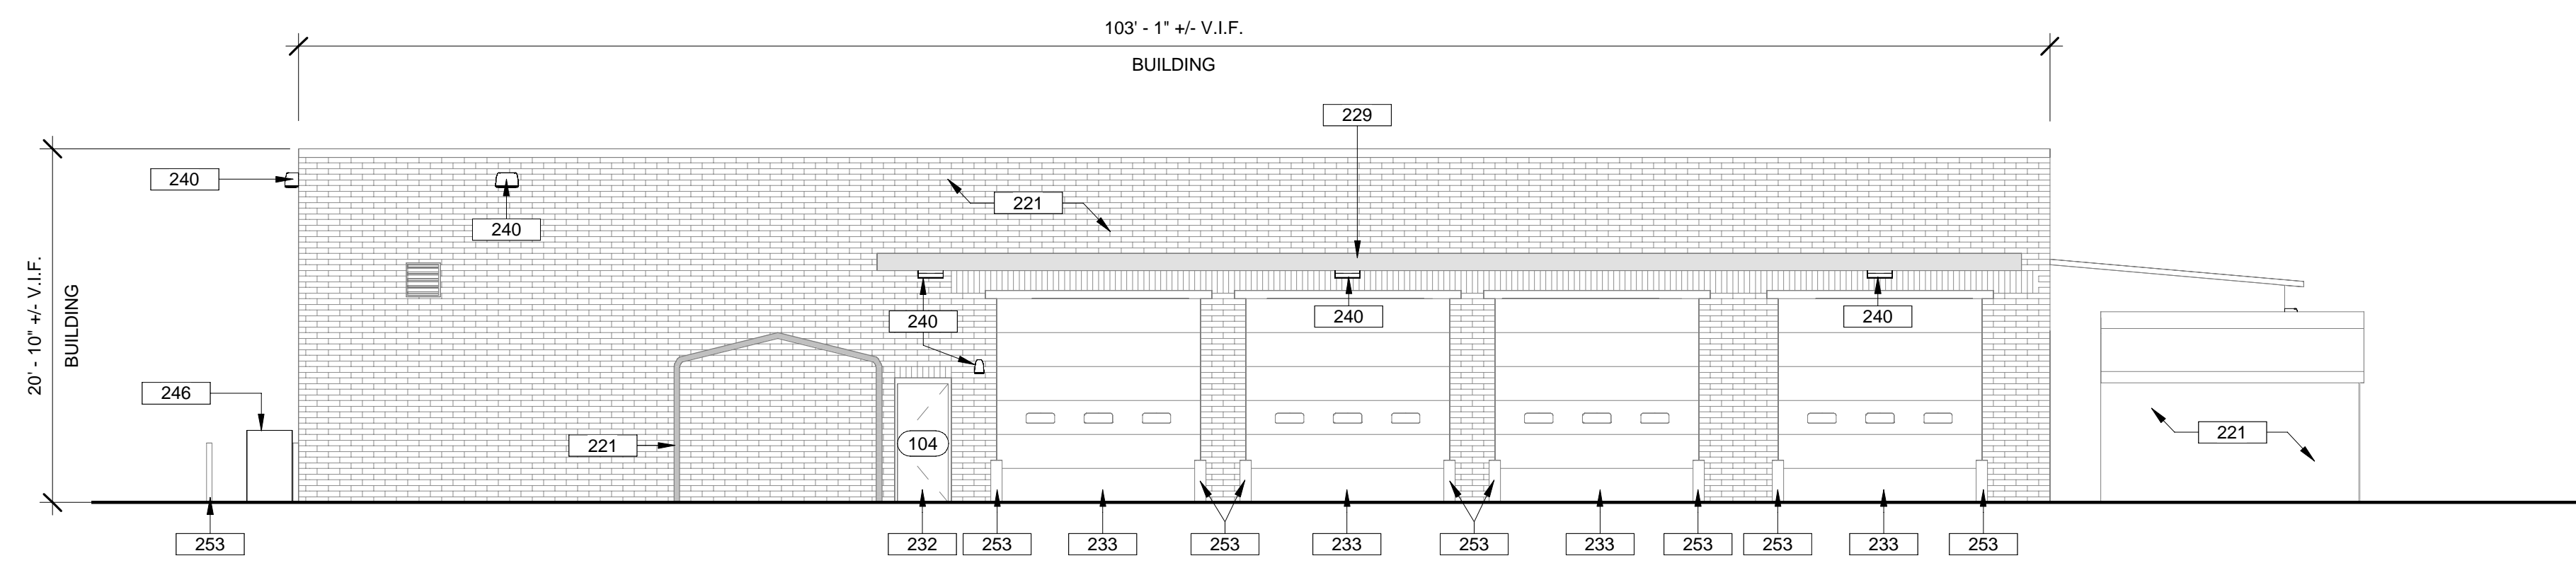


1 NORTH ELEVATION
A200 SCALE: 1/8" = 1'-0"

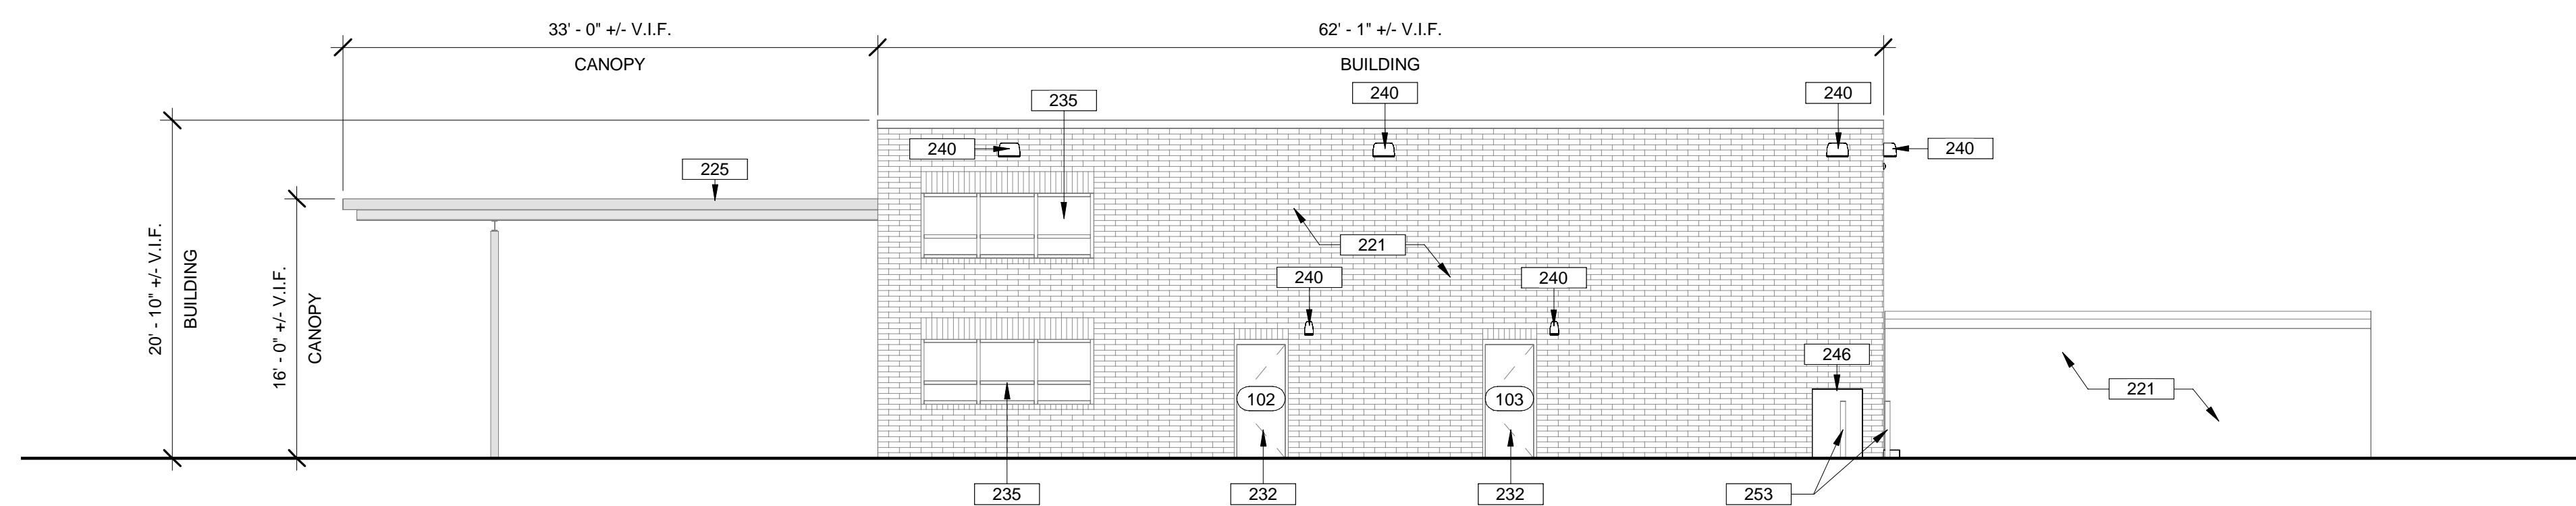

2 EAST ELEVATION
A200 SCALE: 1/8" = 1'-0"

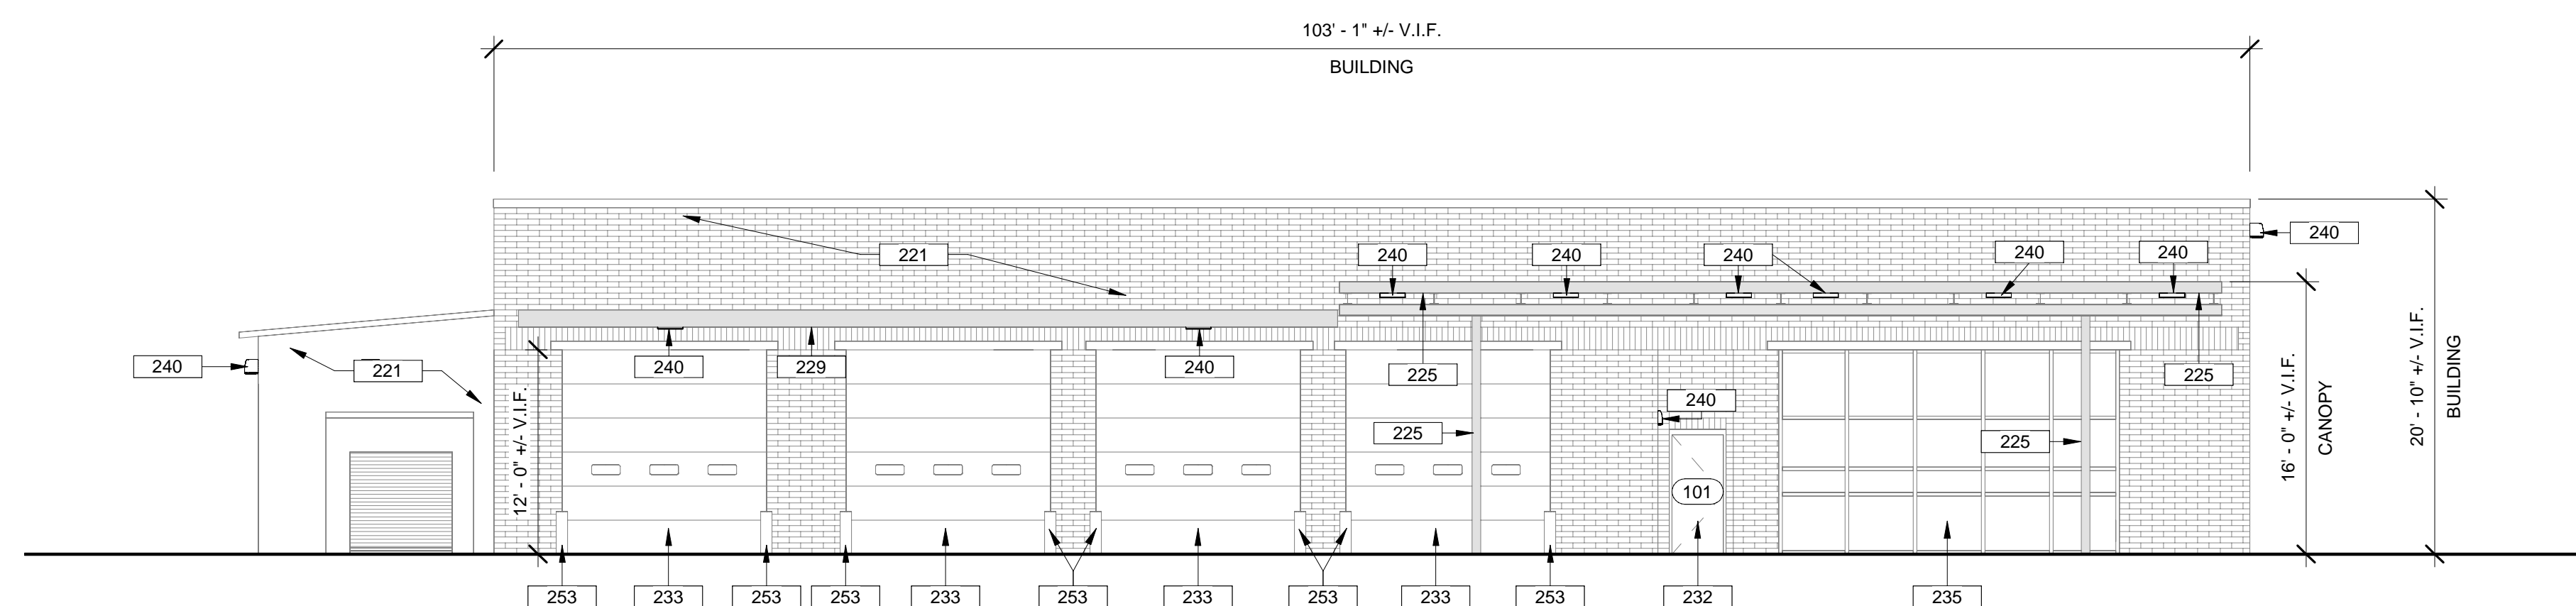

3 SOUTH ELEVATION
A200 SCALE: 1/8" = 1'-0"

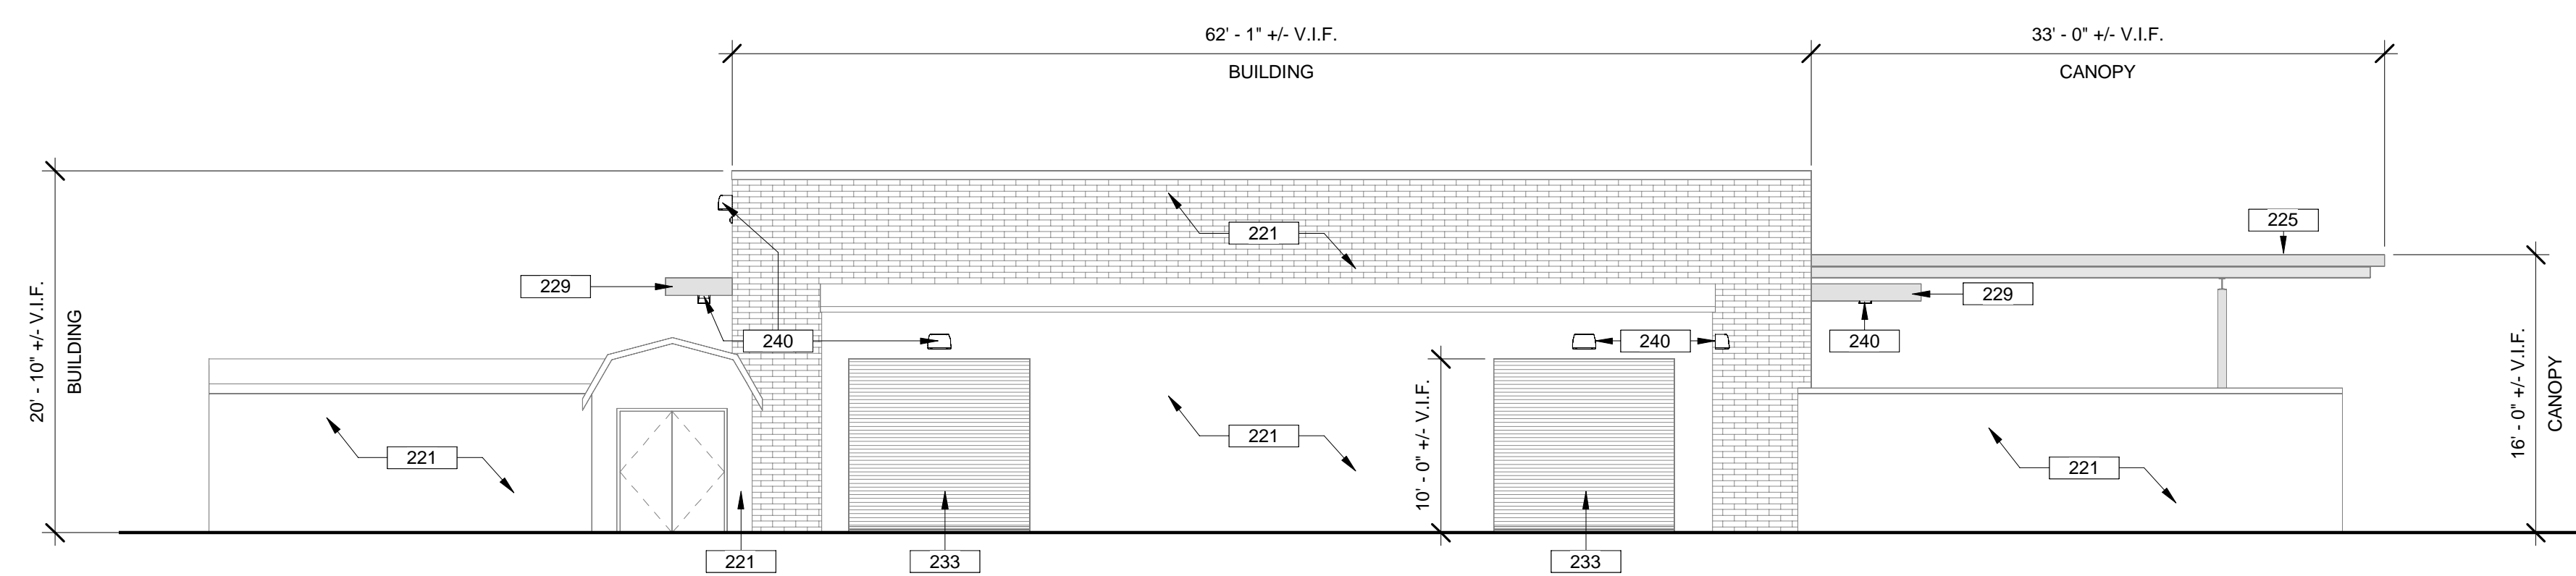


4 WEST ELEVATION
A200 SCALE: 1/8" = 1'-0"

GENERAL NOTES

REFER TO G.002 FOR GENERAL NOTES

KEYNOTES LEGEND


MARK	DESCRIPTION
221	POWER WASH EXTERIOR WALL SURFACES; PAINT EXTERIOR LOUVERS; CLEAN, PREP, AND PRIME AS REQUIRED FOR NEW PAINT; LOUVER COLOR TO MATCH EXISTING; CONTRACTOR TO VERIFY QUANTITY OF LOUVERS.
225	PRESSURE WASH/CLEAN EXISTING CANOPY STRUCTURE; PATCH/REPAIR SURFACE AS REQUIRED.
229	PRESSURE WASH/CLEAN OVERHANG; PAINT EXISTING SOFFIT; CLEAN, PREP, AND PRIME SURFACE TO RECEIVE NEW FINISH; COLOR TO MATCH EXISTING.
232	EXISTING DOOR AND FRAME TO BE PAINTED; CLEAN, PREP AND PRIME AS REQUIRED FOR NEW FINISH; PAINT ALL SIDES AND EDGES OF DOOR/FRAME; REFER TO FINISH SCHEDULE FOR ADDITIONAL INFORMATION; TYP.
233	WASH/CLEAN INTERIOR AND EXTERIOR OF EXISTING OVERHEAD SECTIONAL DOOR AND FRAME ASSEMBLY; TYP.
235	WASH/CLEAN INTERIOR AND EXTERIOR OF EXISTING WINDOW AND FRAME ASSEMBLY; TYP.
240	NEW LIGHT FIXTURE ASSEMBLY/ELECTRICAL EQUIPMENT; TYP. REFER TO ELECTRICAL DRAWINGS FOR ADDITIONAL INFORMATION.
246	EXISTING ELECTRICAL EQUIPMENT; REFER TO ELECTRICAL DRAWINGS FOR SCOPE.
253	PAINT EXISTING BOLLARD SAFETY YELLOW TO COMPLY WITH USPS STANDARDS; CLEAN, PREP AND PRIME AS REQUIRED FOR NEW FINISH; TYP.

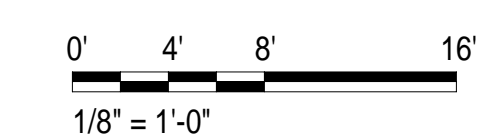

DATE & TIME: 2/5/2024 4:34:03 PM

EXHIBITS

- NGDV CHECKLIST
- CIVIL AUTO-TURN - NDGV
- CIVIL AUTO-TURN - FIRETRUCK
- UNITED STATES POSTAL SERVICE – FACILITIES FORM ECC-EZ
- LIGHTING CALCULATIONS
- EMERGENCY LIGHTING CALCULATIONS
- PHOTOS

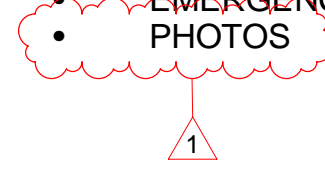

EXHIBITS

Scale: AS NOTED Date: Jan 12, 2024
Project: LYNNWOOD (NORTH)
USPS File Number: E0879

90% DESIGN SUBMITTAL

Revisions:
1. Revision 1 02/02/2024



**UNITED STATES
POSTAL SERVICE**

LYNNWOOD (NORTH)
6821 208TH ST SW
LYNNWOOD, WA 98036

WSP USA INC.
2718 BROADWAY
ST. LOUIS, MO 63102





Detail: Fac. | Ch. | Sect. | Para. | Detail
CAD File: Scale: USPS SDL Issued: Last Revised:



Detail: Fac. | Ch. | Sect. | Para. | Detail
CAD File: Scale: USPS SDL Issued: Last Revised:




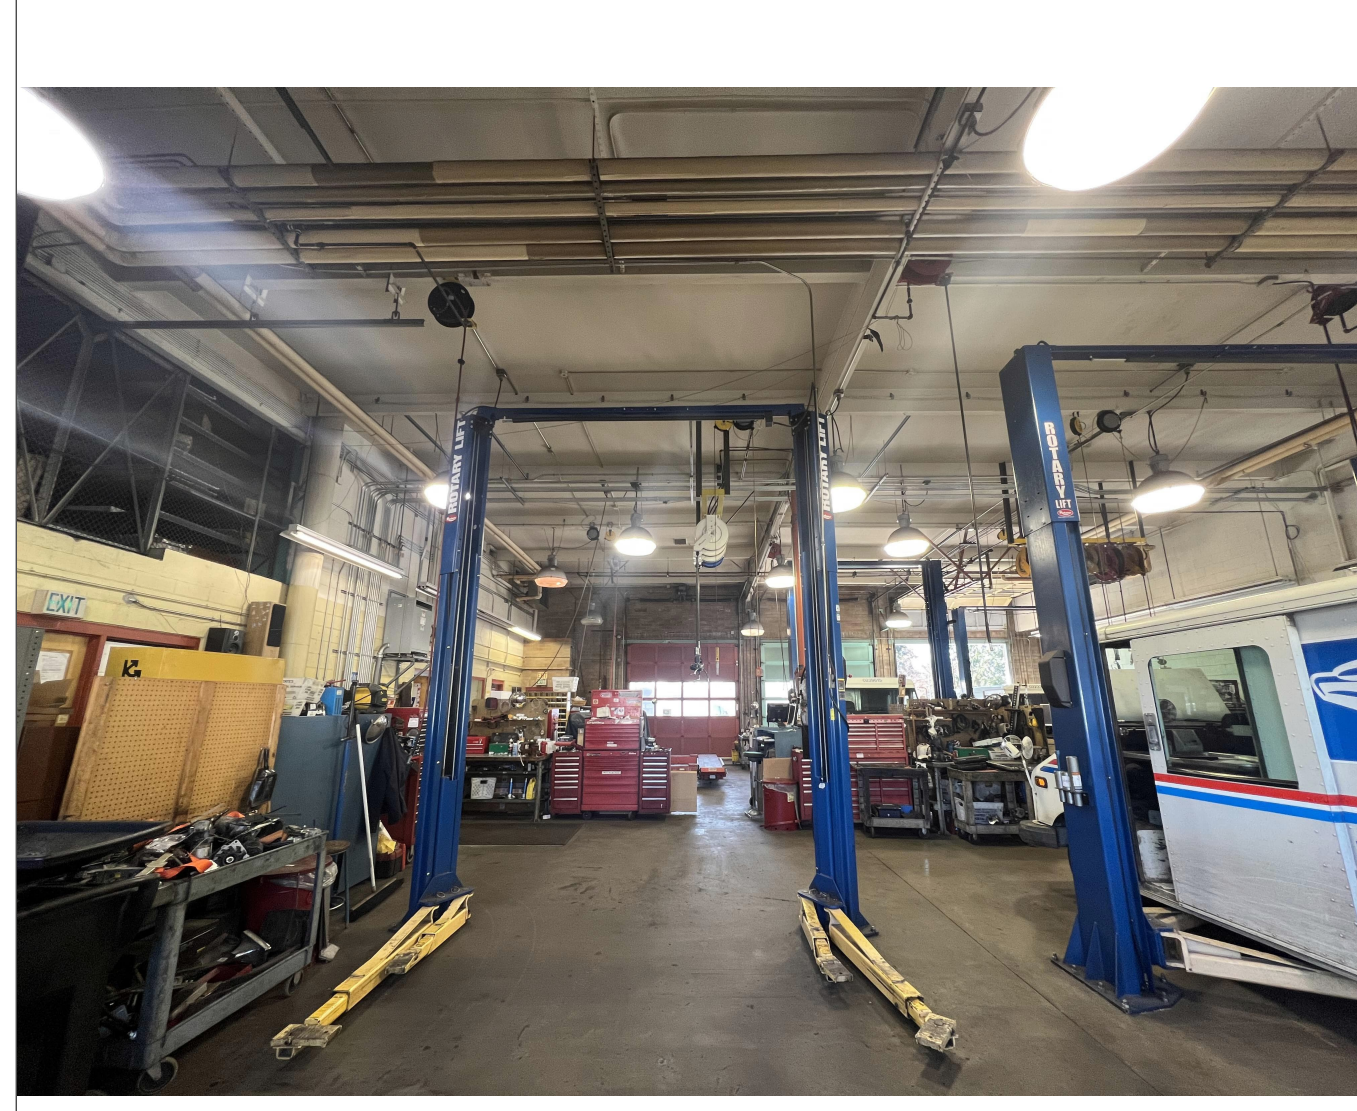

Detail: Fac. | Ch. | Sect. | Para. | Detail
CAD File: Scale: USPS SDL Issued: Last Revised:

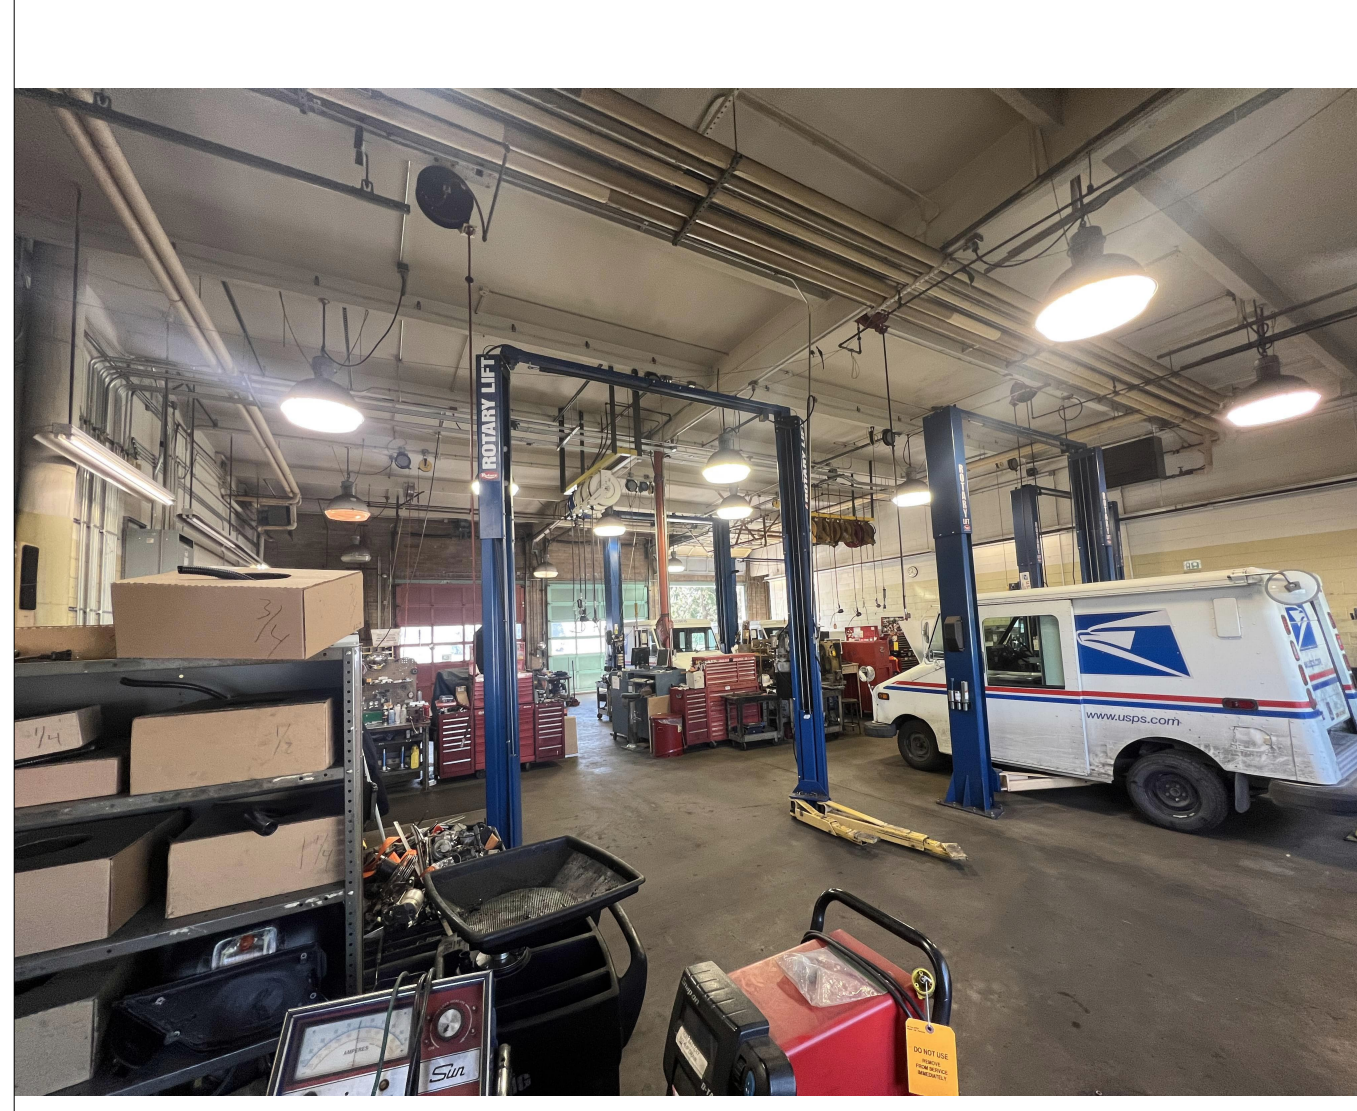

Detail: Fac. | Ch. | Sect. | Para. | Detail
CAD File: Scale: USPS SDL Issued: Last Revised:



Detail: Fac. | Ch. | Sect. | Para. | Detail
CAD File: Scale: USPS SDL Issued: Last Revised:



 


Detail: Fac. | Ch. | Sect. | Para. | Detail
CAD File: Scale: USPS SDL Issued: Last Revised:

 


Detail: Fac. | Ch. | Sect. | Para. | Detail
CAD File: Scale: USPS SDL Issued: Last Revised: