2. SYMBOLS FOR VARIOUS ELEMENTS AND SYSTEMS ARE SHOWN ON THE DRAWINGS. SHOULD THERE BE ANY DOUBT REGARDING THE MEANING OR INTENT OF THE SYMBOLS USED, AN INTERPRETATION SHALL BE OBTAINED FROM THE ARCHITECT IN WRITING. THE DECISION OF THE ARCHITECT SHALL BE FINAL

3. IT SHALL BE THE RESPONSIBILITY OF EACH CONTRACTOR TO EXAMINE THE CONTRACT DOCUMENTS CAREFULLY BEFORE SUBMITTING THEIR BID, WITH PARTICULAR ATTENTION TO ERRORS, OMISSIONS, CONFLICTS WITH PROVISIONS OF LAWS AND CODES HAVING JURISDICTION, CONFLICTS BETWEEN DRAWINGS OR DRAWINGS AND SPECIFICATIONS, AND AMBIGUOUS DEFINITION OF THE EXTENT OF COVERAGE BETWEEN CONTRACTS. ANY SUCH DISCREPANCY SHALL BE BROUGHT IMMEDIATELY TO THE ATTENTION OF THE ARCHITECT FOR CORRECTION. SHOULD ANY OF THESE ERRORS. OMISSIONS. CONFLICTS. OR AMBIGUITIES EXIST, THE CONTRACTOR SHALL HAVE THEM EXPLAINED AND ADJUSTED IN WRITING BEFORE SIGNING THE CONTRACT OR PROCEEDING WITH THE WORK; OTHERWISE, THE CONTRACTOR SHALL AT THEIR OWN EXPENSE, SUPPLY THE PROPER MATERIALS AND LABOR TO MAKE GOOD ANY DAMAGE OR DEFECTS IN THEIR WORK OR THE

RESULTS OBTAINED THEREFROM, CAUSED BY SUCH DISCREPANCY 4. WHEREVER CONFLICTS OCCUR BETWEEN DIFFERENT PARTS OF THE CONTRACT DOCUMENTS, THE GREATER QUANTITY, THE BETTER QUALITY. OR LARGER SIZE SHALL PREVAIL UNLESS THE ARCHITECT INFORMS THE CONTRACTOR OTHERWISE IN WRITING.

5. THE SCALE OF EACH DRAWING IS RELATIVELY ACCURATE; ANY DIMENSIONS SHOWN ARE APPROXIMATE TO CENTERLINE FROM ASSUMED BUILDING PERIMETER. THE CONTRACTOR SHALL OBTAIN THE NECESSARY DIMENSIONS FOR ANY EXACT TAKEOFFS FROM THE ARCHITECT. NO ADDITIONAL COST TO THE OWNER WILL BE CONSIDERED FOR FAILURE TO OBTAIN EXACT DIMENSIONS WHERE NOT CLEAR OR IN ERROR ON THE DRAWINGS. ANY DEVICE OR FIXTURE ROUGHED IN IMPROPERLY AND NOT POSITIONED ON IMPLIED CENTER. LINES OR AS REQUIRED BY GOOD PRACTICE MUST BE REPOSITIONED AT NO COST TO THE OWNER.

6. ONLY EXPERIENCED CRAFTSMEN KNOWLEDGEABLE IN THEIR RESPECTIVE TRADE SHALL PERFORM THE WORK DESCRIBED IN THE CONSTRUCTION DOCUMENTS.

7. ALL WORK SHALL BE DONE IN ACCORDANCE WITH THE LATEST ADOPTED EDITION OF NFPA STANDARD 70 (NATIONAL ELECTRICAL CODE). CONTRACTOR SHALL ALSO CONFORM TO ALL APPLICABLE LOCAL CODES AND AMENDMENTS

8. UNLESS OTHERWISE INDICATED. ALL EQUIPMENT AND MATERIALS SHALL BE NEW AND SHALL MEET NEMA AND ANSI STANDARDS. THEY SHALL ALSO BE LISTED/LABELED BY A NATIONALLY RECOGNIZED LABORATORY IN ACCORDANCE WITH NFPA 70. EQUIPMENT AND MATERIALS SHALL BE INSTALLED IN ACCORDANCE WITH MANUFACTURER'S RECOMMENDATIONS, AND WITHIN THEIR LISTING/LABELING REQUIREMENTS AND RESTRICTIONS.

PROVIDE SHOP DRAWINGS FOR ENGINEER'S REVIEW FOR ALL ELECTRICAL EQUIPMENT, DEVICES, AND MATERIALS PROPOSED TO BE PROVIDED UNDER THIS CONTRACT. ANY DEVIATIONS FROM ITEMS SPECIFIED SHALL BE CLEARLY IDENTIFIED AND SEPARATELY SUBMITTED WITH A FORMAL SUBSTITUTION REQUEST. REFER TO SPECIFICATIONS (PROJECT MANUAL) FOR REQUIREMENTS.

10. PROVIDE MINIMUM 2-HOUR RATED FIRESTOPPING AT ALL ELECTRICAL PENETRATIONS THROUGH WALLS. REFER TO SPECIFICATION SECTION 078400 FIRESTOPPING. REFER TO 078400 SECTION 3.6 SCHEDULES FOR LIST OF ACCEPTABLE FIRESTOPPING ASSEMBLIES

B. ELECTRICAL EQUIPMENT

1. PROVIDE AN IDENTIFICATION NAMEPLATE FOR EACH ELECTRICAL EQUIPMENT. APPURTENANCE DEPICTING THE DESIGNATION INDICATED ON THE DRAWINGS. REFER TO SPECIFICATIONS FOR FURTHER REQUIREMENTS.

2. WEATHERPROOF ENCLOSURES SHALL BE PROVIDED FOR ALL ELECTRICAL EQUIPMENT, DEVICES AND APPURTENANCES (ALL SYSTEMS) INSTALLED OUTDOORS.

3. COORDINATE AND SCHEDULE ALL POWER OUTAGES WITH OWNER

REFER TO SPECIFICATIONS FOR FURTHER REQUIREMENTS 4. SPACE ALLOCATIONS FOR MATERIALS, EQUIPMENT AND DEVICES HAVE BEEN MADE ON THE BASIS OF PRESENT AND KNOWN FUTURE REQUIREMENTS AND THE DIMENSIONS OF ITEMS OF EQUIPMENT OR DEVICES OF A PARTICULAR MANUFACTURER. THE CONTRACTOR SHALL VERIFY THAT ALL MATERIALS, EQUIPMENT AND DEVICES PROPOSED FOR USE ON THIS PROJECT ARE WITHIN THE CONSTRAINTS OF THE

ALLOCATED SPACE. DO NOT USE PERMANENT INK WHEN MAKING FIELD MARKINGS OR TEMPORARY CIRCUIT LABELS ON PANELS. CONTRACTOR SHALL USE REMOVABLE TAPE/TAGS FOR ALL TEMPORARY MARKINGS AND SHALI REMOVE THESE TEMPORARY MARKINGS AT THE CONCLUSION OF THIS 

6. THE SHORT CIRCUIT EQUIPMENT RATINGS WERE SELECTED BASED UPON OBSERVED CONDITIONS AND/OR INFORMATION PROVIDED BY USPS. THE CONTRACTOR SHALL VERIFY THE EXISTING CONDITIONS OF THE ELECTRICAL EQUIPMENT PRIOR TO ORDERING EQUIPMENT AND THE COMMENCEMENT OF CONSTRUCTION. IF ANY DISCREPANCIES ARE FOUND NOTIFY THE ENGINEER AND OWNER IMMEDIATELY TO DETERMINE WHAT CHANGES NEED TO BE MADE.

1. COORDINATE WITH THE SITE WORK FOR THE LOCATION, DIMENSIONS AND ELEVATION OF ALL DUCTBANKS/SERVICE CONDUITS EXTERNAL TO THE BUILDING PRIOR TO INSTALLATION OF ALL DUCTBANKS/SERVICE CONDUITS INTERNAL TO THE BUILDING.

2. COORDINATE ALL ELECTRICAL UTILITY SERVICE REQUIREMENTS WITH UTILITIES REPRESENTATIVE PRIOR TO COMMENCING ANY ELECTRICAL SITE WORK. CONTRACTOR SHALL SCHEDULE ALL NECESSARY MEETINGS BETWEEN UTILITY COMPANIES CONSTRUCTION FOREMAN, ELECTRICAL SUBCONTRACTORS, AND VARIOUS SUBCONTRACTORS RESPONSIBLE FOR SITE CONSTRUCTION PRIOR TO ELECTRICAL ROUGH-

D. CONDUIT & RACEWAY

1. ALL WORK SHALL BE COORDINATED SO THAT INTERFERENCES ARE AVOIDED. PROVIDE ALL NECESSARY OFFSETS IN CONDUITS, RACEWAYS, ETC., REQUIRED TO PROPERLY INSTALL THE WORK. EXPOSED WORK MUST BE KEPT AS CLOSE AS POSSIBLE TO WALLS, CEILINGS, COLUMNS, ETC., SO AS TO TAKE UP MINIMUM AMOUNT OF SPACE; ALL OFFSETS, FITTINGS, ETC., REQUIRED SHALL BE PROVIDED WITHOUT ADDITIONAL EXPENSE TO THE OWNER. WORK SHALL BE COORDINATED WITH OTHER TRADES.

2. CONDUIT RUNS ARE DIAGRAMMATIC IN NATURE. CONTRACTOR IS RESPONSIBLE FOR SIZING AND LOCATING PULL BOXES PER NFPA 70 AND FOR COORDINATION WITH OTHER DISCIPLINES.

3. PENETRATIONS OF WALLS, FLOORS, AND ROOFS FOR THE PASSAGE OF ELECTRICAL RACEWAYS SHALL BE APPROVED BY THE STRUCTURAL ENGINEER OF RECORD PRIOR TO THE COMMENCEMENT OF WORK. ALL SUCH PENETRATIONS SHALL BE PROPERLY SEALED OFF AFTER INSTALLATION OF RACEWAY SO AS TO MAINTAIN THE STRUCTURAL WATER PROOF, AND FIRE PROOF INTEGRITY OF THE WALL, FLOOR, OR ROOF SYSTEM PENETRATED.

4. SEAL ALL CONDUITS THAT PENETRATE THE FLOOR SLAB TO MAKE THEM WATER TIGHT. THE CONDUITS SHALL BE DRIED PRIOR TO INSTALLATION OF WIRE/CABLE AND SHALL BE SEALED AT TERMINATIONS.

5. ALL PENETRATIONS THROUGH FIRE RATED WALLS OR PARTITIONS SHALL BE MADE IN ACCORDANCE WITH U.L. "FIRE RESISTANCE DIRECTORY". PENETRATIONS SHALL BE SLEEVED AND SEALED WITH A UL APPROVED FIRE RATED SEALANT. REFER TO ARCHITECTURAL PLANS FOR FIRE RATED WALLS.

6. ALL EMPTY CONDUIT SYSTEMS SHALL CONTAIN A PULL WIRE FOR

FUTURE PULLING OF CONDUCTORS. 7. OR FROM BUILDING CONTROL POWER DISTRIBUTION SYSTEM. E. BRANCH CIRCUITS AND FEEDERS

1. CIRCUITING IS SHOWN DIAGRAMMATICALLY 2. UNLESS OTHERWISE INDICATED, ALL CIRCUITS 100' OR LESS SHALL BE MINIMUM #12 AWG WIRE SIZE. CIRCUITS OVER 100' BUT LESS THAN 200' SHALL BE MINIMUM #10 AWG WIRE SIZE. CIRCUITS OVER 200' BUT LESS THAN 300' SHALL BE MINIMUM #8 AWG WIRE SIZE

98% CONDUCTIVITY CONTINUOUS FROM OUTLET TO OUTLET. 4. UNLESS OTHERWISE INDICATED, CONDUCTOR SIZES #12 AWG AND #10 AWG SHALL BE SOLID. CONDUCTOR SIZES #8 AWG AND LARGER MAY BE STRANDED. 5. A SEPARATE INSULATED EQUIPMENT GROUNDING CONDUCTOR SHALL

UNLESS OTHERWISE INDICATED, ALL CONDUCTORS SHALL BE COPPER,

BE PULLED WITH THE CIRCUIT CONDUCTORS FOR GROUNDING WHETHER OR NOT INDICATED ON THE DRAWINGS, METAL RACEWAY, OR A CABLE ARMOR OR SHEATH SHALL NOT BE USED AS THE ONLY EQUIPMENT GROUNDING CONDUCTOR

6. HOMERUN CIRCUITS FOR ISOLATED GROUND RECEPTACLES SHALL BE SEPARATED FROM OTHER CIRCUITS. EACH CIRCUIT SHALL HAVE ITS OWN NEUTRAL CONDUCTOR AND EACH HOMERUN SHALL CONTAIN AN ISOLATED AND EQUIPMENT GROUND CONDUCTOR.

F. WIRING DEVICES

1. REFER TO ARCHITECTURAL DRAWINGS AND SPECIFICATIONS FOR LOCATION AND MOUNTING HEIGHT OF ALL WALL AND FLOOR MOUNTED ELEMENTS (OUTLETS, LIGHT SWITCHES, CONTROLLERS, POKE-THRU ETC). ALL WALL/FLOOR MOUNTED ITEMS SHALL BE INSTALLED IN ACCORDANCE WITH THE ARCHITECTURAL DIMENSIONED DRAWINGS. IF LOCATION FOR AN ITEM IS NOT SHOWN ON THE ARCHITECTURAL DRAWINGS, VERIFY THE EXACT LOCATION OF THE ITEM WITH THE ARCHITECT PRIOR TO INSTALLATION. THESE REQUIREMENTS APPLY TO ALL WALL/FLOOR TYPES IN ALL AREAS. DO NOT SCALE OR DIMENSION LOCATIONS FROM THESE DRAWINGS.

2. COORDINATE THE LOCATION AND INSTALLATION DETAIL OF OUTLETS IN MILLWORK WITH ARCHITECTURAL DRAWINGS (WALL ELEVATIONS, MILLWORK DETAILS. ETC.) AND WITH MILLWORK MANUFACTURER PRIOR TO ELECTRICAL ROUGH-IN.

3. WALL AND FLOOR MOUNTED POWER RECEPTACLES SHOWN NEAR DATA OUTLETS SHALL BE LOCATED WITHIN SIX (6) INCHES OF THE DATA OUTLET. LOCATE AT SAME MOUNTING HEIGHT UNLESS NOTED OTHERWISE.

4. VERIFY THE EXACT POWER CONNECTION TYPE AND NEMA CONFIGURATION OF RECEPTACLES FOR EQUIPMENT FURNISHED BY THE OWNER, OTHER TRADES, OR UNDER A SEPARATE SECTION OF THIS CONTRACT PRIOR TO ELECTRICAL ROUGH-IN.

ALL RECEPTACLES LOCATED OUTSIDE THE BUILDING ENVELOPE SHALL BE HOUSED IN ENCLOSURES THAT ARE RATED 'WEATHER-PROOF-WHILE-IN-USE' AND SHALL BE EQUIPPED WITH GFCI FOR PERSONNEL

6. ALL GFCI RECEPTACLES SHALL BE CONNECTED SO THAT ALL DEVICES ON THE SAME CIRCUIT AS THE GFCI RECEPTACLE DO NOT DE-ENERGIZE UPON TRIPPING. ALL GFCI RECEPTACLES SHALL INCLUDE A LOCK-OUT FUNCTION TO PROTECT AGAINST THE USE OF MISWIRED DEVICES OR DEVICES THAT HAVE BEEN DAMAGED DUE TO DISABLING SURGES.

<u>G. LIGHTING SYSTEM</u>

PROTECTION.

1. REFER TO ARCHITECTURAL DRAWINGS AND SPECIFICATIONS FOR LOCATION OF ALL CEILING ELEMENTS (LIGHTS, SPRINKLERS, DIFFUSERS, ETC). ALL CEILING MOUNTED ITEMS SHALL BE INSTALLED IN ACCORDANCE WITH THE ARCHITECTURAL DIMENSIONED DRAWINGS. IF LOCATION FOR AN ITEM IS NOT SHOWN ON THE ARCHITECTURAL DRAWINGS, VERIFY THE EXACT LOCATION OF THE ITEM WITH THE ARCHITECT PRIOR TO INSTALLATION. THESE REQUIREMENTS APPLY TO ALL CEILING TYPES IN ALL AREAS. DO NOT SCALE OR DIMENSION LOCATIONS FROM THESE DRAWINGS.

2. PROVIDE AND INSTALL ALL SUPPORTS FOR LIGHT FIXTURES. SUPPORTS SHALL BE INDEPENDENT OF THE CEILING GRID SUPPORT SYSTEM. 3. LIGHT SWITCHES / OCCUPANCY SENSORS LOCATED IN A ROOM SHALL

CONTROL ALL THE LIGHT FIXTURES IN THAT ROOM UNLESS NOTED OTHERWISE. CONTRACTOR SHALL GANG TOGETHER ALL SWITCHES/DIMMERS UNDER A SINGLE COVER PLATE IN ALL AREAS THAT REQUIRE MORE THAN ONE SWITCH TO CONTROL ELECTRICAL DEVICES.

4. IN INSTANCES WHERE A TRACK LIGHTING SYSTEM, DIMMING SYSTEM, AND/OR LIGHTING CONTROL SYSTEM IS SPECIFIED, THE CONTRACTOR SHALL COORDINATE ALL NECESSARY COMPONENTS OF SUCH SYSTEM(S) WITH THE MANUFACTURER PRIOR TO BID AND INCLUDE ALL NECESSARY ACCESSORIES TO INSTALL A COMPLETE AND FUNCTIONING

H. 2-POST LIFT COORDINATION

1. LIFTS MAY BE PROVIDED AS PART OF PROJECT SCOPE OR BY USPS. REVIEW DRAWINGS AND LIFT SCHEDULE FOR SITE SPECIFIC INFORMATION

2. MINIMUM VERTICAL CLEARANCE ABOVE ALL LIFTS IS 15'-3".

3. COORDINATE WITH GENERAL CONTRACTOR TO PROVIDE MINIMUM 15'-3" CLEARANCE ABOVE ALL NEW LIFTS, WHETHER LIFT(S) ARE PROVIDED AS PART OF SCOPE OF WORK FOR THE PROJECT OR PROVIDED BY OWNER. MAKE SAFE AND DISCONNECT ANY EQUIPMENT, DEVICES, LIGHTS, AND/OR CONDUIT WITH POWER RUNNING ALONG LIFT VEHICLE CLEARANCE AREA THAT INTERFERES WITH 15'-3" MINIMUM VERTICAL CLEARANCE REQUIREMENT. COORDINATE WITH GENERAL CONTRACTOR TO SHIFT/ADJUST ANY ELECTRICAL

DEVICE/EQUIPMENT/RACEWAY/WIRING/ELEMENT RUNNING ALONG VERTICAL CLEAR AREA BEYOND 15'-3". 4. ANY NEW LIGHTING, CONTROLS, POWER, CONDUIT AND

APPURTENANCES ROUTED AS PART OF THE PROJECT SHALL NOT INTERFERE WITH VEHICLE LIFT CLEARANCE AREA. 5. REFER TO A500 FOR LIFT CLEARANCE DETAIL.

6. THIS SCOPE OF WORK DOES NOT APPLY TO ALIGNMENT LIFTS.

J. DEMO GENERAL NOTES

1. PROVIDE UPDATED, TYPE WRITTEN DIRECTORY OF ALL CORRECT CIRCUITS WITH LOAD DEFINITIONS FOR EACH PANEL BOARD. DIRECTORY SHALL BE LOCATED INSIDE PANEL DOOR.

2. INFORMATION PROVIDED ON THESE DRAWINGS HAVE BEEN TAKEN FROM DESIGN DRAWING AND FIELD OBSERVATIONS CONTRACTOR SHALL VERIFY ALL EXISTING CONDITIONS PRIOR TO PRICING AND COMMENCEMENT OF WORK.

3. WHERE EXISTING WALLS ARE DEMOLISHED, REMOVE ALL EXISTING ELECTRICAL DEVICES AND THEIR ASSOCIATED CONDUITS AND WIRING BACK TO THE POINT OF ORIGINATION. ENERGIZE ALL EXISTING DEVICES THAT WERE INTERRUPTED DURING DEMOLITION. WHERE ENTIRE CIRCUITS ARE REMOVED, TURN THE CIRCUIT BREAKER OFF AND LABEL AS "SPARE"

4. PROVIDE FOR ANY AND ALL DEMOLITION WORK NECESSARY TO ACCOMMODATE ALL NEW CONSTRUCTION, INCLUDING ARCHITECTURAL, MECHANICAL, PLUMBING OR ELECTRICAL WORK.

5. IF DEMOLITION IS REQUIRED TO INSTALL AN ITEM, THE CONTRACTOR SHALL RESTORE THE AREA TO PREVIOUS CONDITION, OR REPLACE

DAMAGED ITEMS WITH NEW ITEMS TO MATCH EXISTING. 6. DESIGNATION 'EX' REPRESENTS EXISTING DEVICE OR LIGHT FIXTURE TO REMAIN AS CIRCUITED AND SWITCHED UNLESS NOTED OTHERWISE EXISTING LIGHT FIXTURES SHALL BE CLEANED AND REPAIRED AS

7. A DEVICE WITH AN 'X' INDICATES EXISTING DEVICE TO BE REMOVED INCLUDING ALL ASSOCIATED CONDUIT AND WIRING.

8. A DEVICE WITH AN 'R' INDICATES EXISTING DEVICE TO BE RELOCATED INCLUDING ALL ASSOCIATED CONDUIT AND WIRING. 9. CONTRACTOR SHALL REMOVE ALL CONDUIT AND WIRING ASSOCIATED WITH DEVICES AND EQUIPMENT TO BE REMOVED AND/OR RELOCATED UNLESS NOTED OTHERWISE. PROVIDE AND INSTALL ALL NECESSARY DEVICES, EQUIPMENT AND ACCESSORIES REQUIRED TO MAINTAIN

MAY BE INTERRUPTED DURING DEMOLITION. 10. WHERE EXISTING MECHANICAL/PLUMBING EQUIPMENT IS DEMOLISHED, REMOVE ALL RELATED ELECTRICAL FEEDS TO THE EQUIPMENT AND THEIR ASSOCIATED CONDUITS BACK TO THE POINT OF ORIGINATION.

SERVICE TO ALL "EXISTING TO REMAIN" DEVICES AND EQUIPMENT THAT

11. REFER TO ARCHITECTURAL PLANS FOR AREAS WHERE CEILING IS DEMOLISHED. REMOVE ALL LIGHTING FIXTURES AND ASSOCIATED CONDUIT AND WIRING FROM THESE LOCATIONS.

**ELECTRICAL ABBREVIATIONS** ABOVE FINISHED COUNT ABOVE FINISHED FLOOP **AUTHORITY HAVING JUP** AUTOMATIC TRANSFER BELOW FINISHED CEILIN **BOTTOM OF FIXTURE** CONDUIT CIRCUIT BREAKER **CKT BKR** CIRCUIT CLOSED CIRCUIT T.V. CEILING CRITICAL (EMERGENCY CABINET HEATER ELECTRICAL CONTRACT ELEC ELECTRIC **EMERGENCY ENERGY MANAGEMENT** EXPLOSION PROOF ELECTRIC VEHICLE SUP **EWC** ELECTRIC WATER COOL **EXISTING** FIRE ALARM FACP. FAP FIRE ALARM CONTROL F FAN COIL UNIT FIXTURE FLOOR **FLUORESCENT** FLUOR FTP, FTS OR FAN TERMINAL UNIT FUTURE G, GND GROUND (EQUIPMENT) GENERAL EXHAUST FAN **GENERATOR** GROUND FAULT CIRCUIT GFCI, GFI HORSE POWER HIGH VOLTAGE HEAT TRACE INTERRUPTING CAPACIT ICAND INCANDESCENT ISOLATED GROUND GROUND FAULT INDICAT JUNCTION BOX KITCHEN EXHAUST FAN LIGHTING LIGHTS LOW VOLTAGE MASTER ANTENNA MAIN CIRCUIT BREAKER MOTOR CONTROL CENT MAIN DISTRIBUTION PAN MANHOLE MAIN LUGS ONLY MOUNT OR MOUNTED MICROWAVE NEW DEVICE NC (N.C.) NORMALLY CLOSED NATIONAL ELECTRIC CO **NEMA** NATIONAL ELECTRICAL ASSOCIATION NONFUSED NOT IN CONTRACT NIGHT LIGHT NORMALLY OPEN OVERHEAD PULL BOX PLGMLD PLUGMOLD PANEL POWER RELOCATED DEVICE RECEPTACLE(S) RECEPT REFRIGERATOR RETURN AIR FAN SMOKE EXHAUST FAN SUPPLY AIR FAN SO (S.O.) SPACE ONLY SHUNT TRIP SWITCH TELEPHONE TRANSFER FAN TAMPER PROOF TELEVISION TRANSIENT VOLTAGE SU SUPPRESSION UNDERFLOOR UNDERGROUND UNIT HEATER UNK (U.N.K.) UNKNOWN UNO (U.N.O.)  $\,$  UNLESS NOTED OR INDI $\,$ OTHERWISE VARIABLE FREQUENCY DRIVE VAPOR PROOF VARIABLE VOLUME UNIT WIRE GUARD WEATHER PROOF WATER TIGHT TRANSFORMER MOUNTING HEIGHT IN INCHES. AFF UNO. UNDER CABINET REFRIGERATOR

		POWER SYMBOLS LEGEND	
ITER R		ALL SYMBOLS SHOWN MAY NOT APPEAR IN ALL DRAWING YMBOLS ARE SHOWN SCHEMATIC AND MAY NOT BE TO SCA	_
RISDICTION SWITCH NG	SYMBOL	DESCRIPTION	M
	0	SINGLE RECEPTACLE - 20A/125V/2P/3W/G NEMA 5-20R	+
	₽	DUPLEX RECEPTACLE - 20A/125V/2P/3W/G NEMA 5-20R	<u> </u>
	<b>-</b>	DUPLEX RECEPTACLE ON EMERGENCY CIRCUIT	
SYSTEM)	₽	DUPLEX RECEPTACLE GFCI	
TOR	⊕ <sub>WP</sub>	DUPLEX RECEPTACLE, GFCI, TAMPER RESISTANT, WEATHER RESISTANT, HOUSED IN A "WEATHERPROOF-WHILE-IN-USE" ENCLOSURE - 20A/125V/2P/3W/G NEMA 5-20R	
SYSTEM	€	DUPLEX RECEPTACLE MOUNTED ABOVE COUNTERTOP	6
PPLY EQUIPMENT LER	<del> </del>	QUADRUPLEX RECEPTACLE (TWO DUPLEX RECEPTACLES UNDER ONE COVERPLATE)	+
5445	<b>+</b>	QUADRUPLEX RECEPTACLE ON EMERGENCY CIRCUIT (TWO DUPLEX RECEPTACLES UNDER ONE COVERPLATE)	
PANEL	8	SPECIAL PURPOSE RECEPTACLE (NEMA AS INDICATED)	
	•	FLOOR MOUNTED RECEPTACLE IN FLOOR BOX OR POKE- THRU DEVICE - FLUSH MOUNTED, UNO	t
	- <b>\$</b> -	CEILING MOUNTED RECEPTACLE - CONFIGURATION UNO	Ť_
	ΟЮ	JUNCTION BOX - SIZE & MOUNTING AS REQUIRED	<u></u>
N T INTERRUPTER	₩ <sub>D/T</sub>	WALL MOUNTED JUNCTION BOX FOR DATA/TELEPHONE - SIZE & MOUNTING AS REQUIRED	
I INTERNOTIE:		POWER POLE	
		PLUGMOLD  DISCONNECT SWITCH	
TY	\ \ X/Y/Z	DISCONNECT SWITCH (X=FRAME SIZE, Y=FUSE SIZE, Z=NUMBER OF POLES)	≤
TION ONLY	\_X/-/Z	DISCONNECT SWITCH NON-FUSED (X=FRAME SIZE, Z=NUMBER OF POLES)	≤
	\$ <sub>M</sub>	MANUAL MOTOR STARTER SWITCH WITH THERMAL OVERLOAD AND PILOT LIGHT	
	宁	EMERGENCY POWER OFF BUTTON - WALL MOUNTED	/
R TER		208Y/120V PANELBOARD	≤
NEL	_	480Y/277V PANELBOARD	≤
		208Y/120V DISTRIBUTION PANELBOARD	≤
ODE		480Y/277V DISTRIBUTION PANELBOARD	≤
MANUFACTURERS		SWITCHBOARD	
	T	STEP-DOWN TRANSFORMER	
		AUTOMATIC TRANSFER SWITCH	
	<u></u>	GROUND BAR	
	ATS	AUTOMATIC TRANSFER SWITCH ANNUNCIATOR PANEL	/
		GENERAL NOTATIONS AND MOUNTING HEIGHTS	_
	DEVICE, U A) 24" AFF B) 42" AFF C) 60" AFF	ALL MOUNTING HEIGHTS REFER TO BOTTOM OF JNLESS OTHERWISE INDICATED. FINDICATES TO BOTTOM OF DEVICE; FINDICATES TO CENTER OF DEVICE; FINDICATES TO BOTTOM OF DEVICE; FINDICATES TO BOTTOM OF DEVICE;	
		CONFIRM ALL BACKBOX SIZE WITH VENDOR SHOP IS PRIOR TO ELECTRICAL ROUGH-IN.	
SURGE	(2) - L	LEGEND NOTES: DENOTES "SEE LEGEND NOTE NO. 2"	
ICATED		DENOTES: REFERENCE DETAIL 02 ON DRAWING (SHEET) E100	
ICATED		DENOTES: REFERENCE ENLARGED DETAIL PLAN 02 ON DRAWING (SHEET) E100	

ĹĴ	DRAWING (SHEET) E100	
717629 OR 717629	- EQUIPMENT (ID) NUMBER FOR OWNER PROVIDED EQUIPMENT. REFER TO OWNER'S EQUIPMENT BOOK / FF&E DOCUMENTS FOR DEFINITION AND REQUIREMENTS.	
		_
	CODES AND STANDARDS	_
2018	CODES AND STANDARDS  WASHINGTON STATE BUILDING CODE	
2018 2018		_
	WASHINGTON STATE BUILDING CODE	
2018	WASHINGTON STATE BUILDING CODE  WASHINGTON STATE EXISTING BUILDING CODE  ICC/ANSI A117.1 ACCESSIBLE AND USABLE BUILDINGS AND	

**POWER SYMBOLS LEGEND** 

MNTG. HT.

(U.N.O.)

24" AFF

24" AFF

6" AFC OR

24" AFF

24" AFF

**FLOOR** 

CLNG

AS REQ'D

≤ 6' - 0" AFF

≤ 6' - 0" AFF

TO TOP

AS REQ'D

AS REQ'D

≤ 6' - 0" AFF

TO TOP

≤ 6' - 0" AFF

TO TOP

≤ 6' - 0" AFF

TO TOP

TO TOP

| ≤ 6' - 0" AFF

AS REQ'D

TO TOP

44" AFF

_0.0	
2018	WASHINGTON STATE EXISTING BUILDING CODE
2009	ICC/ANSI A117.1 ACCESSIBLE AND USABLE BUILDINGS AND FACILITIES DESIGN STANDARD
2018	INTERNATIONAL ENERGY CONSERVATION CODE (IECC) WITH STATE AMENDMENTS
2018	WASHINGTON STATE MECHANICAL CODE
2018	FUEL GAS CODE OF WASHINGTON
2018	WASHINGTON STATE PLUMBING CODE
2020	NATIONAL ELECTRIC CODE (NEC / NFPA 70)
2018	INTERNATIONAL FIRE CODE (IFC)
2005	USPS STANDARDS FOR FACILITY ACCESSIBILITY (RE-4)
2023	USPS STANDARDS DESIGN CRITERIA
2009	USPS BUILDING AND SITE SECURITY REQUIREMENTS HANDBOOK RE-5

	YMBOLS ARE SHOWN SCHEMATIC AND MAY NOT BE TO SCA	
SYMBOL	DESCRIPTION	MNTG. HT. (U.N.O.)
	2'x4' LIGHT FIXTURE	NOTE 3
	2'x4' LIGHT FIXTURE (EMERGENCY)	NOTE 3
	2'x2' LIGHT FIXTURE	NOTE 3
	2'x2' LIGHT FIXTURE (EMERGENCY)	NOTE 3
	WALL MOUNTED LINEAR FIXTURE	NOTE 2
<u> </u>	WALL MOUNTED LINEAR FIXTURE (EMERGENCY)	NOTE 2
	RECESSED/SURFACE MOUNTED LINEAR FIXTURE	NOTE 3
////// <u>/</u>	RECESSED/SURFACE MOUNTED LINEAR FIXTURE (EMERGENCY)	NOTE 3
0 🗆	RECESSED/SURFACE DOWNLIGHT FIXTURE	NOTE 3
Ø Ø	RECESSED/SURFACE DOWNLIGHT FIXTURE (EMERGENCY)	NOTE 3
Ω Д	WALL MOUNTED FIXTURE	NOTE 2
Q Q	WALL MOUNTED FIXTURE (EMERGENCY)	NOTE 2
0>	RECESSED DOWNLIGHT FIXTURE WITH WALL WASH	NOTE 3
<b>③</b>	RECESSED DOWNLIGHT FIXTURE WITH WALL WASH (EMERGENCY)	NOTE 3
	HANGING RECTANGULAR PENDANT FIXTURE	NOTE 4
V//////	HANGING RECTANGULAR PENDANT FIXTURE (EMERGENCY)	NOTE 4
	HANGING CIRCULAR PENDANT FIXTURE	NOTE 4
	HANGING CIRCULAR PENDANT FIXTURE (EMERGENCY)	NOTE 4
4	EMERGENCY LIGHTING UNIT. WALL MOUNTED BATTERY-POWERED LIGHTING. CONNECT TO NORMAL CIRCUIT IN AREA SERVED	7'-6" A.F.F. U.N.O.
<b>⊗ ⊗ ©</b>	CEILING MOUNTED EXIT SIGN. SHADING INDICATES DOUBLE OR SINGLE FACE. ARROW INDICATES CHEVRON DIRECTIONS.	NOTE 2
<b>⊗</b> † <b>⊙</b> †	END MOUNTED EXIT SIGN. SHADING INDICATES DOUBLE OR SINGLE FACE. ARROW INDICATES CHEVRON DIRECTIONS.	NOTE 2
፟ 🕏	WALL MOUNTED EXIT SIGN. SHADING INDICATES DOUBLE OR SINGLE FACE. ARROW INDICATES CHEVRON DIRECTIONS.	NOTE 2
무	WALL PACK LIGHT FIXTURE	NOTE 2
<b>Z</b>	WALL PACK LIGHT FIXTURE (EMERGENCY)	NOTE 2
<u>~</u> ₩	EXTERIOR LIGHT POLE FIXTURE ON NORMAL CIRCUIT.	NOTE 2
•	SPOT/FLOOD LIGHT FIXTURE.	
\$	WALL SWITCH SPST, 20A, 120/277V	NOTE 5
\$ <sub>D</sub>	WALL DIMMER SWITCH	NOTE 5
\$ <sub>K</sub>	KEY OPERATED WALL SWITCH	NOTE 5
\$ <sub>LV</sub>	LOW VOLTAGE WALL SWITCH	NOTE 5
	WALL SWITCH WITH PILOT LIGHT	NOTE 5
\$ <sub>P</sub>		

	<u>LIOITINO NOTEO.</u>
ı	1. ALL SYMBOLS SHOWN MAY NOT APPEAR IN ALL DRAWINGS. SYMBOLS ARE
ı	SHOWN SCHEMATIC AND MAY NOT BE TO SCALE.
ı	<ol><li>REFER TO LIGHT FIXTURE SCHEDULE FOR SPECIFIC FIXTURE INFORMATION.</li></ol>

3. REFER TO ARCHITECTURAL REFLECTED CEILING PLANS FOR MOUNTING HEIGHTS. IT IS THE INTENT, UNLESS NOTED OTHERWISE, THAT SURFACE AND RECESSED FIXTURES ARE TO BE MOUNTED AT ARCHITECTS CEILING

. REFER TO ARCHITECTURAL REFLECTED CEILING PLANS AND ELEVATIONS FOR MOUNTING HEIGHTS OF PENDANT FIXTURES. REFER TO LIGHTING FIXTURE SCHEDULE FOR PENDANT MATERIAL

REFER TO ARCHITECTURAL DRAWINGS FOR TYPICAL MOUNTING HEIGHTS. WHERE MOUNTING HEIGHT IS NOT INDICATED BY ARCHITECT, PROVIDE AT 42" AFF TO CENTER.

	OCCUPANCY SENSOR/CONTROLS SYMBOLS LEGEND									
	ALL SYMBOLS SHOWN MAY NOT APPEAR IN ALL DRAWINGS. SYMBOLS ARE SHOWN SCHEMATIC AND MAY NOT BE TO SCALE.									
SYMBOL	DESCRIPTION	MNTG. HT. (U.N.O.)								
(OS)	OCCUPANCY SENSOR, DUAL TECHNOLOGY	CLNG								
<b>⊘</b> s> <sup>US</sup>	OCCUPANCY SENSOR, ULTRASONIC	CLNG								
⟨VS⟩DT	VACANCY SENSOR, DUAL TECHNOLOGY	CLNG								
\$ <sub>0</sub>	WALL SWITCH OCCUPANCY SENSOR CONTROL	NOTE 1								
\$ <sub>OT</sub>	WALL TIMER SWITCH OCCUPANCY SENSOR CONTROL	NOTE 1								
\$ <sub>V</sub>	WALL SWITCH VACANCY SENSOR CONTROL	NOTE 1								
1. REFE	NCY SENSOR/CONTROLS NOTES: R TO ARCHITECTURAL ELEVATIONS FOR EXACT MOUNTING L DEVICES.	HEIGHTS								

SHEET INDEX							
Sheet Number	Sheet Name						
E001	ELECTRICAL GENERAL INFORMATION						
ES100	ELECTRICAL SITE PLAN						
ED100	ELECTRICAL DEMOLITION PLAN						
E100	ELECTRICAL POWER & LIGHTING PLANS						
E400	ELECTRICAL ONE-LINE DIAGRAM						
E401	ELECTRICAL SCHEDULES						
E500	ELECTRICAL DETAILS						
E501	ELECTRICAL DETAILS						

WSP USA INC

211 N. BROADWA

0 0

\_\_\_\_

WSP USA INC.

211 N. BROADWAY,

9	<u> </u>		~~~			& CONDUIT SCI			~~~	····	
	TAG	AMPACITY		PHASE	N	EUTRAL		BROUND	CONDUIT		
4	1710	7 ((())	NO. WIRES	SIZE (AWG OR KCMIL)	NO. WIRES	SIZE (AWG/KCMIL)	NO. WIRES	SIZE (AWG/KCMIL)	QTY.	SIZE	
	80/2	80	2	#3	-	-	1	#8	1	1"	
}	100/2	100	2	#2	-	-	1	#8	1	1 1/4"	
(	NOTES:										

- 1. SIZES BASED ON THWN CONDUCTORS AND PVC/EMT CONDUIT SIZES IN NEC TABLE 9. EXTERIOR CONDUCTORS SHALL BE 90° XHHW.
- 2. AMPACITY BASED ON NEC.
- 3. FEEDERS SERVING TRANSFORMERS DO NOT REQUIRE A GROUND. FOR TRANSFORMERS GEC, MATCH SIZE OF EGC

  ✓ SHOWN ON FEEDER SCHEDULE.
- 4. COMPACT STRANDED ALUMINUM CONDUCTORS MAY BE USED FOR CONDUCTORS #1/0 AND LARGER IF EQUIPPED WITH COMPRESSION LUGS AND INSTALLED PER MANUFACTURER'S INSTRUCTIONS.


Liming the state of the state o


ELECTRICAL LOA (985- LYNNW)	
UTILITY PROVIDER	SNOHOMISH COUNTY PUD
UTILITY CONTACT	Karl Haack kjhaack@snopud.com 425 670 3208
VMF FED BY MAIN BUILDING	NO
EXISTING MAIN BUILDING TRANSFORMER SIZE (IF APPLICABLE)	150KVA
VMF DISTRIBUTION VOLTAGE	480/277V
EXISTING VMF TRANSFORMER SIZE	112 KVA
EXISTING VMF DISTRIBUTION SIZE (MCB)	400 A
VMF BUILDING CAPACITY (80% OF MCB)	320 A
EXISTING ELEC PEAK LOAD (AS PER UTILITY)	118 KW (BOTH BUILDINGS)
EXISTING PEAK LOAD MONTH	Sep-14
NEC EXISTING LOAD FACTOR OF 25% PEAK	29.5 KW
REMAINING CAPACITY	101.4 KW (BOTH BUILDINGS) EC HAS TO METER VMF PANEL-VM FOR SPARE CAPACITY
ADDED CHARGER LOAD	(2) CHARGERS AT 19,200 W EACH =38.4 KW (240V 1Ø)
UTILITY UPGRADE NEEDED	NO
FEEDER FROM MAIN BUILDING UPGRADE NEEDED (IF APPLICABLE)	NO

NOTES: SCOPE OF WORK IS RENOVATION OF EXISTING BUILDING. ONLY NEW/ADDED LOADS ARE SHOWN ON PANEL SCHEDULES. EXISTING LOAD VALUES ARE NOT KNOWN AND DEPICTED AS 0.

NOTES PEAK CONSUMPTION INFORMATION

OBTAINED FROM UTILITY

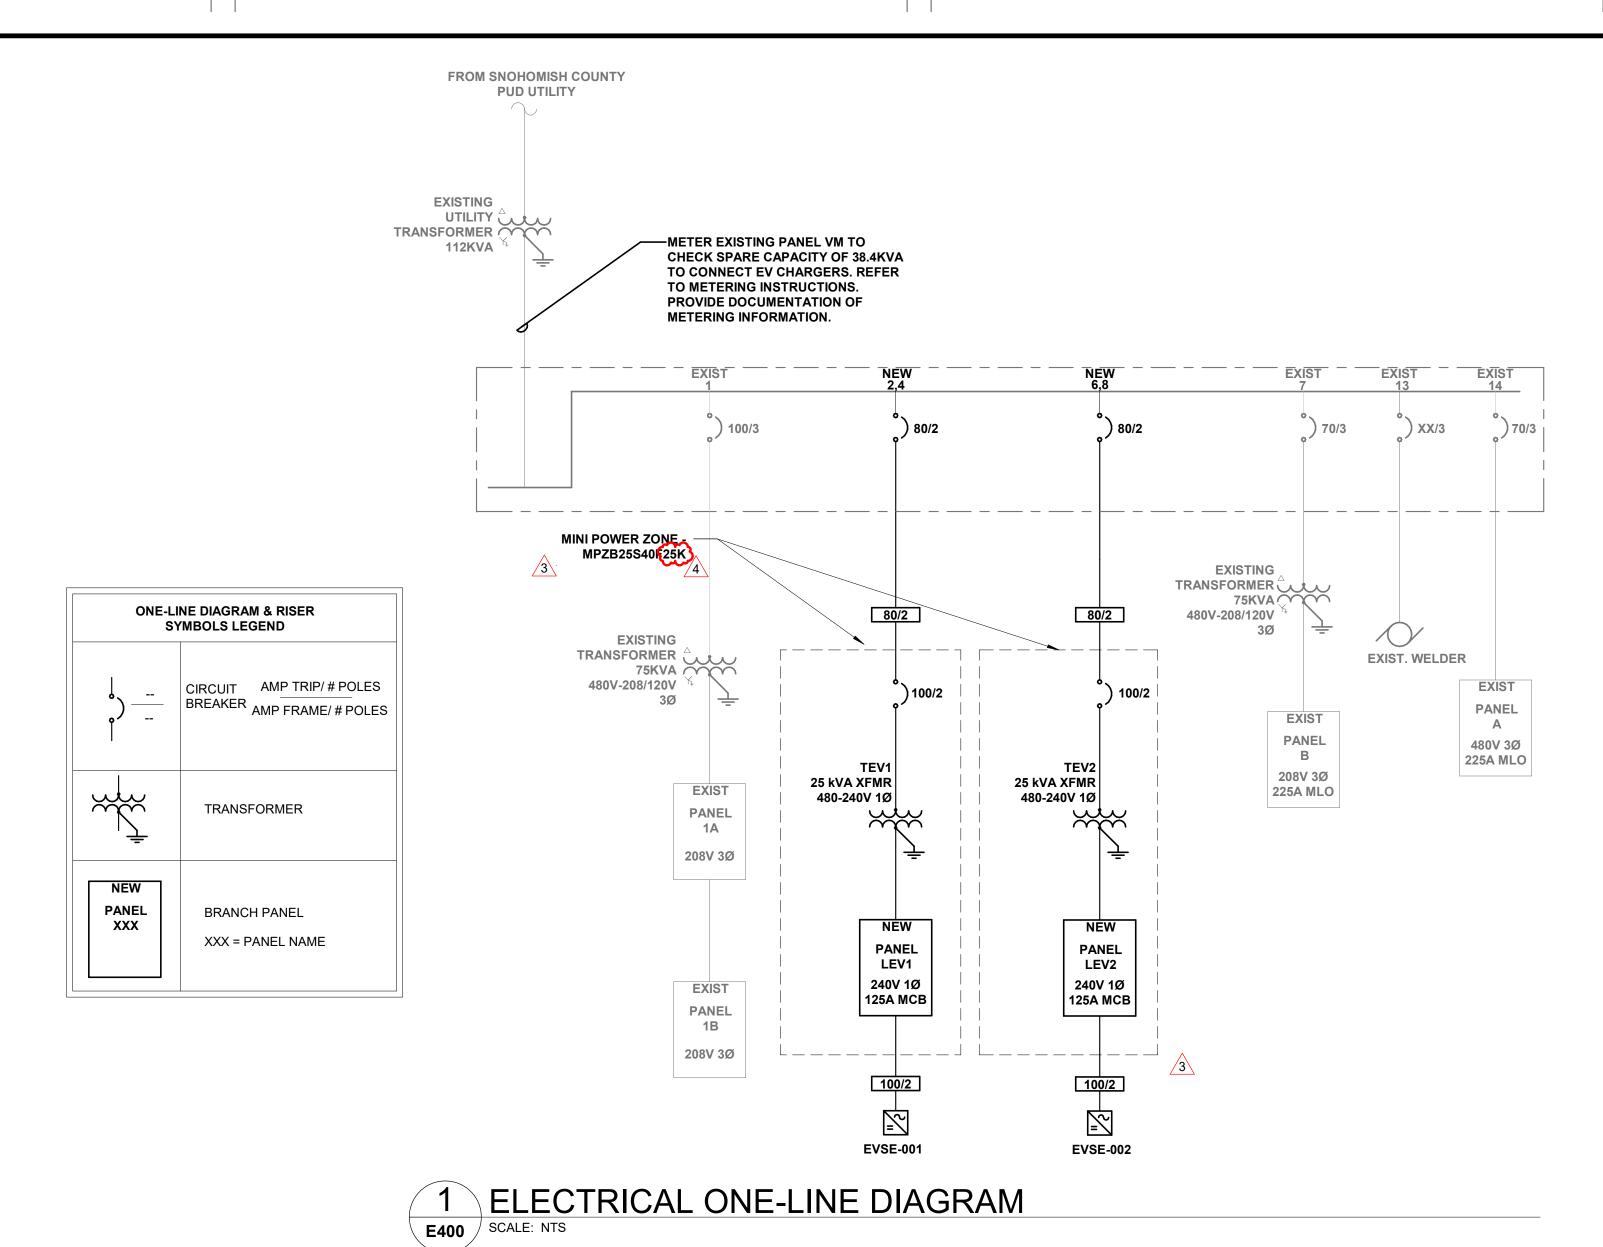

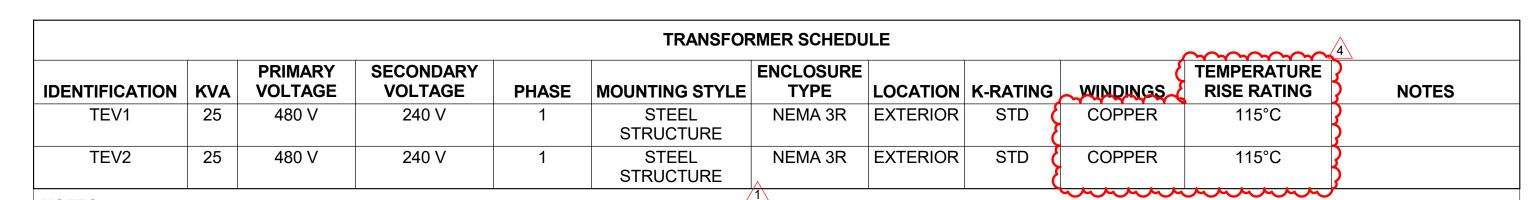

1. STOCK OPTIONS HAVE BEEN SPECIFIED DUE TO CONSTRUCTION SCHEDULE. EQUIPMENT LEAD TIMES HAVE BEEN COORDINATED WITH SCHNEIDER FOR 22.5/25 kVA MINI

2. REFER TO CIVIL DRAWING DETAILS FOR MOUNTING INFORMATION.

				EVS	E SCHEDUL	E						
EVSE#	EV KIT#	DESCRIPTION	LOCATION	PHASE	VOLTS	MAXIMUM CURRENT	ELECTRICAL OUTPUT (W)	CB RATING	POLES	FEE INFOR PANEL	REMARKS	
EVSE-001	CP001	240V 1Ø - 80A (100A BREAKER)	EXTERIOR	1	240 V	80 A	19,200	100 A	2	LEV1	1,3	
EVSE-002	CP001	240V 1Ø - 80A (100A BREAKER)	EXTERIOR	1	240 V	80 A	19,200	100 A	2	LEV2	1,3	

							LII	FTS ELECTR	ICAL R	EQUIREMENTS SO	HEDULE											
	DISCONNECT CONTROL DEVICE FEEDER INFORMATION																					
						<b>ENCLOSURE</b>	FURNISHED	INSTALLED		SWITCH/ FUSE		FURNISHED	WIRED				(L.C.)	(	GND)	(CNDT)		
NAME	DESCRIPTION	LOCATION	HP	VOLTAGE PHASE	MCA MOCE	TYPE	BY	BY	TYPE	SIZE	LOCATION	BY	BY	TYPE P	ANEL	CIRCUIT	QTY	INE	QTY GROUND	QTY	CONDUIT	REMARKS

								OVERHEAD D	OOR ELEC	TRICAL REQUIRE	MENT SCHEDULE									
									DI	SCONNECT		CONT	ROL DEVICE	<b>.</b>				FEEDER INF	ORMATION	
						ENCLOSURI	FURNISHED	INSTALLED		SWITCH/ FUSE		FURNISHE	WIRED			CIRCUIT	(L.C.)	(GND)		(CNDT)
NAME	DESCRIPTION	LOCATION	HP	<b>VOLTAGE</b>	PHASE MCA MO	P TYPE	BY	BY	TYPE	SIZE	LOCATION	BY	BY .	TYPE	<b>PANEL</b>		`QTY <sup>´</sup> LINI	`QTY	GROUND	QTY CONDUIT REM

			LIGHT	ING FIXTURE SCHEE	ULE				
TYPE	COUNT	DESCRIPTION	MOUNTING	COLOR TEMP.	LUMENS	VA	VOLTAGE	MANUFACTURER	CATALOG NUMBER
EM4	4	WALL MOUNTED EMERGENCY EXIT DISCHARGE LIGHT, SELF DIAGNOSTIC LITHIUM IRON PHOSPHATE BATTERY, FIELD CONFIGURABLE THROW OPTICS.	WALL-8' AFF	-	-	12	277 V	LITHONIA	AFFOELDWHGXDUVOLTLTPSDRTFCT
MH3	7	WALL MOUNTED LED LIGHT, TYPE 4 DISTRIBUTION, WHITE FINISH, IP 65 RATED, WET LOCATION LISTED.	WALL-11' AFF	4,000K	2863	29	277 V	LITHONIA	MRWLED P2 40K SR4 MVOLT PIR DWXHD
PL1	23	EXTERIOR SURFACE MOUNTED LED CANOPY LIGHTS, DIE CAST ALUMINUM HOUSING, TYPE 5 MEDIUM DISTRIBUTION, IP66 RATED, WET LOCATION LISTED.	SURFACE MOUNTED	4,000K	10092	107	277 V	LITHONIA	DSXSC LED 30C 1000 40K T5M MVOLT SRM PIR3FC3V DWHXD
W3	25	2'X2' HIGH BAY SUSPENDED LED LIGHT, TEXTURED ACRYLIC LENS, WIDE DISTRIBUTION, SUPER DURABLE WHITE COLOR FINISH, DIE CAST ALUMINUM HOUSING, THERMOSET POWDER COAT FINISH, WET LOCATION LISTED, IP65 RATED.	CABLE- 18' AFF	4,000K	148690	97	277 V	LITHONIA	XIB L24 15000LM ATWD MVOLT GZ10 40K 80CRI WGX DHWXD
W3E	5	2'X2' HIGH BAY SUSPENDED LED LIGHT, TEXTURED ACRYLIC LENS, WIDE DISTRIBUTION, SUPER DURABLE WHITE COLOR FINISH, DIE CAST ALUMINUM HOUSING, THERMOSET POWDER COAT FINISH, WET LOCATION LISTED, IP65 RATED. PROVIDE WITH SELF-DIAGNOSTIC BATTERY PACK.		4,000K	14860	97	277 V	LITHONIA	XIB L24 15000LM ATWD MVOLT GZ10 40K 80CRI NLTAIR2 RMSOD45 DHWXD E15WMCP
X1	6	SINGLE FACE WALL MOUNTED SELF POWERED AND SELF-DIAGNOSTICS LED EXIT LIGHT, WHITE HOUSING COLOR, RED COLORED LETTERS, NICKEL CADMIUM BATTERY.	ABOVE DOOR	N/A	N/A	1	277 V	LITHONIA	LQM S W 3 R 120/277 ELN SD
NOTES:	-		•	1	,	•		·	•

REQUIREMENTS

LIGHTING FIXTURE SCHEDULE IS BASIS OF DESIGN AND SUBSTITUTIONS BASED ON SPECIFICATIONS SECTION 26 51 00 IS ACCEPTABLE, HOWEVER, ANY SUBSTITUTES CHOSEN SHALL MEET CONSTRUCTION DEADLINE. CONTRACTOR SHALL REFER TO SPECIFICATIONS FOR ADDITIONAL REQUIREMENTS. EC TO PROVIDE MOUNTING HARDWARE FOR WALL/CEILING/PENDENT MOUNT.

PROVIDE WITH LUMINAIRE MOUNTED OCCUPANCY SENSORS AS PER SCHEDULE.

OVERRIDE MANUAL SWITCH PHOTOCELL INTERMATIC OR TORK K4141C OR 2002 TIME CLOCK INTERMATIC OR TORK ET70000 OR ELC	1
TIME CLOCK INTERMATIC OR TORK FT70000 OR FLC	1
SERIES	1
TIME SWITCH nLIGHT ACUITY nPOD MA 2L	5

		NORMAL BUSINESS HOURS		AFTER BUSINESS HOURS			OCCUPANCY	SENSOR		MANUAL O\	/ERRIDE	EMERGENC'
TAG	SPACE TYPE	LIGHTING	RECEPTACLES	LIGHTING	RECEPTACLES	CONTROL SYSTEM TYPE	TYPE / LOCATION	SETPOINT	PHOTOCELL CONTROL	DEVICE	DURATION	FIXTURES CONTROLLE
01	VEHICLE SERVICE BAY	OCCUPANCY SENSOR ACTIVATES TO 50%. OFF AFTER 20 MINUTES OF INACTIVITY	N/A	NO CHANGE	N/A	STANDALONE	DUAL-TECH / INTEGRAL	AUTO ON TO 50% / OFF IN 20 MIN	N/A	TIMER SWITCH - HIGH OUTPUT	4 HRS	NO
03	WASH BAY	OCCUPANCY SENSOR ACTIVATES TO 50%. OFF AFTER 20 MINUTES OF INACTIVITY	N/A	NO CHANGE	N/A	STANDALONE	DUAL-TECH / INTEGRAL	AUTO ON TO 50% / OFF IN 20 MIN	N/A	TIMER SWITCH - HIGH OUTPUT	4 HRS	NO
04	EXTERIOR LIGHTING	CONTROLLED VIA PHOTOCELL ONLY	N/A	FOR THE TIME BETWEEN 1 HOUR AFTER BUSINESS HOURS AND 1 HOUR PRIOR TO BUSINESS HOURS; CONTROLLED BY PHOTOCELL AND OCCUPANCY SENSOR	N/A	STANDALONE	TIME CLOCK/PHOTOCELL/ OCCUPANCY SENSOR	AUTO ON TO 100% / OFF IN 20 MIN	YES	ON/OFF VIA ASTRONOMICAL TIME CLOCK, PHOTOCELL, AND OCCUPANCY CONTROLS	OFF HOURS	N/A
05	EXTERIOR CANOPY	CONTROLLED VIA PHOTOCELL ONLY	N/A	FOR THE TIME BETWEEN 1 HOUR AFTER BUSINESS HOURS AND 1 HOUR PRIOR TO BUSINESS HOURS; CONTROLLED BY PHOTOCELL AND OCCUPANCY SENSOR	N/A	STANDALONE	TIME CLOCK/PHOTOCELL/ OCCUPANCY SENSOR	AUTO ON TO 100% / OFF IN 20 MIN	YES	ON/OFF VIA ASTRONOMICAL TIME CLOCK, PHOTOCELL, AND OCCUPANCY CONTROLS	OFF HOURS	N/A

SETPOINTS AND TIME SCHEDULES MUST BE VERIFIED WITH OWNER PRIOR TO PROGRAMMING.

PROVIDE QUANTITY AND COVERAGE PATTERN OF OCCUPANCY/VACANCY SENSORS WHERE REQUIRED BY THIS SCHEDULE TO COVER ENTIRE ROOM/SPACE CONTROLLED. QUANTITY AND LOCATION OF SENSORS INDICATED ON DRAWINGS IS FOR COORDINATION AND PRICING PURPOSES, AND SHALL BE VERIFIED BY SELECTED MANUFACTURER PRIOR TO SUBMISISON OF SHOP DRAWINGS.

PROVIDE NUMBER OF RELAYS/POWER PACKS TO CONTROL ALL LIGHTING ZONES AND CIRCUITS SHOWN ON PLANS.

PROVIDE UNSWITCHED HOT CONDUCTOR TO FIXTURES WITH INTEGRAL BATTERY PACKS TO SENSE POWER LOSS.

NO DAYLIGHTING IS PROVIDED IN THIS PROJECT DUE TO DISTANCE OF CEILING GRIDS/LIGHT FIXTURES FROM WINDOWS.

WASH BAYS WHICH HAVE LIFTS INSTALLED ARE CONSIDERED TO HAVE BEEN REPURPOSED INTO VEHICLE SERVICE BAYS. ENVIRONMENT IS CONSIDERED TO BE THE SAME AS VEHICLE SERVICE BAYS.

WIRELESS CONTROLS ENCOURAGED FOR WORK BAY HIGH BAY FIXTURES. PROVIDE HEAD END EQUIPMENT, POWER TO EQUIPMENT, AND PROGRAMMING AS NECESSARY TO PROVIDE A COMPLETE AND FULLY FUNCTIONAL SYSTEM.

EACH MANUAL COUNTDOWN TIMER MUST BE DIGITAL TYPE MOUNTED AT 48" AFF TO ALLOW FOR LIGHTING FOR THE HIGH OUTPUT LEVEL ILLUMINATION ZONE TO BE ENERGIZED FOR UP TO (4) HOURS WITH OCCUPANCY DETECTION. SWITCH MUST BE LABELED FOR IDENTIFICATION AS DIRECTED BY USPS PERSONNEL.

	NEW: LEV2 LOCATION: EXTERIOR MAIN BUS: 125 A MCB: 125A VOLTAGE: 120/240V Si		W ENCLOS BUS 1 MOUN	ROM: TEV: IRES: 2W - SURE: NEM TYPE: COP TING: STE .UGS: MCE	· G A 3R PER EL STR	UCTURE	NEUTRAL BUS: NO GROUND BUS: YES AIC AVAILABLE: AIC RATING: 18000 A							
CKT NO.	DESCRIPTION	TRIP	POLES		A (VA)	B (VA	B (VA)		TRIP	DESCR	PTION	CKT NO.		
1	EVSE-002	100 A	2	9600				1		SPACE		2		
<b>3</b>	SPACE		1			9600		1 1		SPACE SPACE		6		
TOTAL LOAD (VA) TOTAL CURRENT (AMPS)  LOAD CLASSIFICATION CONNECTED LOAD						9,600 80.0 ED DEMANI VA)	A	PANEL TOTALS						
EV CHARGER		1	9,200		19	,200					kVA	AMPS		
										INECTED LOAD:	19.2	80		
								TOTA	L ESTIM	ATED DEMAND:	19.2	80		
OTES	<u> </u> 													

	MAIN BUS: 125 A MCB: 125A VOLTAGE: 120/240V				ENCLOS BUS MOUN	VIRES: 2W SURE: NE TYPE: CO ITING: STI LUGS: MO	MA 3R PPER EEL STR	UCTURE		NEUTRAL B GROUND B AIC AVAILAE AIC RATI	SUS: YES	A 3
CKT NO.	DESCRIPTION	TRIP	POLES	(	A (VA)	E (V		POLES	TRIP	DESCRIPTION		CKT NO.
1	EVSE-001	100 A	2	9600		0000		1		SPACE		2
<b>3</b>	SPACE		1			9600		1		SPACE SPACE		6
		OAD (VA) T (AMPS)		0.0 VA	9,600 80.				1017102			
I	LOAD CLASSIFICATION	CONNECT	TED LOAD	(VA)		ED DEMAI VA)	ID			PANEL TOTALS	5	
	EV CHARGER	1		19					kVA	AMPS		
								TOT	TAL CON	INECTED LOAD:	19.2	80
								TOTA	L ESTIM	ATED DEMAND:	19.2	80
OTES	:											

FED FROM: TEV1

NEW: LEV1

	MAIN BUS: 400 A  MCB: N/A  VOLTAGE: 480/277V					ENCLOS BUS MOUN	/IRES: 4\ SURE: NI TYPE: ITING: SI LUGS: M	EMA 1 URFAC	NEUTRAL BUS: YES GROUND BUS: YES AIC AVAILABLE: AIC RATING MIN 16kA						
CKT NO.	DESCRIPTION	TRIP	POLES	A (VA)		B (VA)			C (VA)		TRIP	DESCRIPTION		CKT NO.	
1	EXIST. PANEL 1A&1B XFMR	100	3	0	9600	0	9600			2	80	TEV1 (NOTE-1	)	2	
5 7	75KVA		0	9600		9000	0	9600	2	80	TEV2 (NOTE-1	)	6 8		
9 EXIST. PANEL B VIA T-B	EXIST. PANEL B VIA T-B	70	3		3000	0				1		SPACE (NOTE	(-2)	10	
11								0		1		SPACE (NOTE		12	
13	EVICT MELDED				0		0004				70	EVIOT DANIEL	Δ.	14	
15 17	EXIST. WELDER		3				2664		2939	3	70	EXIST. PANEL	. A	16 18	
	TO	19,2	200 VA	12,2	64 VA	12,5	39 VA			l		10			
	TOTAL C	69	9.5 A	44.3 A		45	5.4 A								
	LOAD CLASSIFICATION	AD (VA	)	ADDED ESTIMATED DEMAND (VA)			PANEL TOTALS								
	LGHT		5,603	<b> </b>			,603						kVA	AMPS	
	EV CHARGER		38,400	)		38	3,400		EX	KISTING	CTED LOAD:	TBD	TBD		
									RE	MOVED	CONNE	CTED LOAD:	TBD	TBD	
										Ţ	OTAL A	DDED LOAD:	44	52.9	
								7	TOTAL A	DDED ES	STIMAT	ED DEMAND:	44	52.9	
NC	OTES: 1. PROVIDE 80A/2P CIRC 2. REMOVE EXISTING SF	_			_				- 40 4115	40.40.0	DA OF				

	XISTING: PANEL LOCATION: HALLWAY 1 MAIN BUS: 225 A MCB: N/A VOLTAGE: 480/277V W	ENCLOSURE: NEMA 1 GROUND BUS TYPE: AIC AVAILA											BUS: YES BUS: YES ABLE: TING MIN 16KA		
CKT DESCRIPTION NO.		TRIP	POLES		A /A)	B (VA)		C (VA)		POLES	TRIP	DESCRIPTION			CKT NO.
1	EXIST. LUBE ROOM LIGHTS	20	1	0	0					1	20	EXIST. BALCO			2
3 EXIST. LUBE ROOM LIGHTS			1			0	2664			1	20	EXT & CANOP			4
5	EXIST. LUBE ROOM LIGHTS	20	1					0	0	1	20	EXIST. OFFICE	E & HALL LT	S	6
7	EXIST. HYD PUMP & AIR			0	0										8
9	COMPR	40	3			0	0			3	30	EXIST. HOT W	ATER TANK		10
11	Com 1							0	0						12
13	EXIST. AIR HAND UNIT & AIR			0	0							EXIST. GAS IS	LAND POLE		14
15	COMPR	20	3			0	0			3	20	LIGHT			16
17								0	0						18
19 21	EXIST. VEHICLE EXHAUST FAN	20	3	0	0	0	0			3	30	EXISTING LOA	ND.		20 22
23	EXIST. VEHICLE EXHAUST FAIN	20	3			U	U	0	0	3	30	EXISTING LOP	AD.		24
25	EXISTING LOAD	20	1	0	0				-	1	20	EXIST. GAS IS	I AND ELOC	חח	26
27	EXISTING LOAD	20	1		0	0	0			1	20	EXISTING LOA			28
	EXISTING LOAD	20	1					0	2939	1		LTG-ROOMS 1		)TF-2)	
			AD (VA)	0	VA	2.66	4 VA		939 VA				1010102 (110	, , <u> </u>	
	TOTAL CUI		` , _		0 A		.1 A		2.1 A						
	LOAD CLASSIFICATION	AD (VA)		ADDED E	STIMAT	PANEL TOTALS									
	LGHT		5,603	}		5	,603						kVA	AM	PS
									Eλ	(ISTING	CONNE	CTED LOAD:	TBD	TE	3D
									RE	MOVED	CONNE	CTED LOAD:	TBD	TE	BD.
												DDED LOAD:	5.6	6.	7
									TOTAL A			ED DEMAND:	5.6	6.	7
													0.0		•
NC	OTES: 1. DEMO EXISTING CIRCU	IT CON	IDUITS A	ND CO	NNECT	NFW LIG	HTING T	O THE	FXISTING	G CIRCUI	IT BRE	AKER.			